


223-19



223-19

SILVER QUEEN P A N L N^o 2 WORKINGS

— Scale 30 ft to 1 Inch —

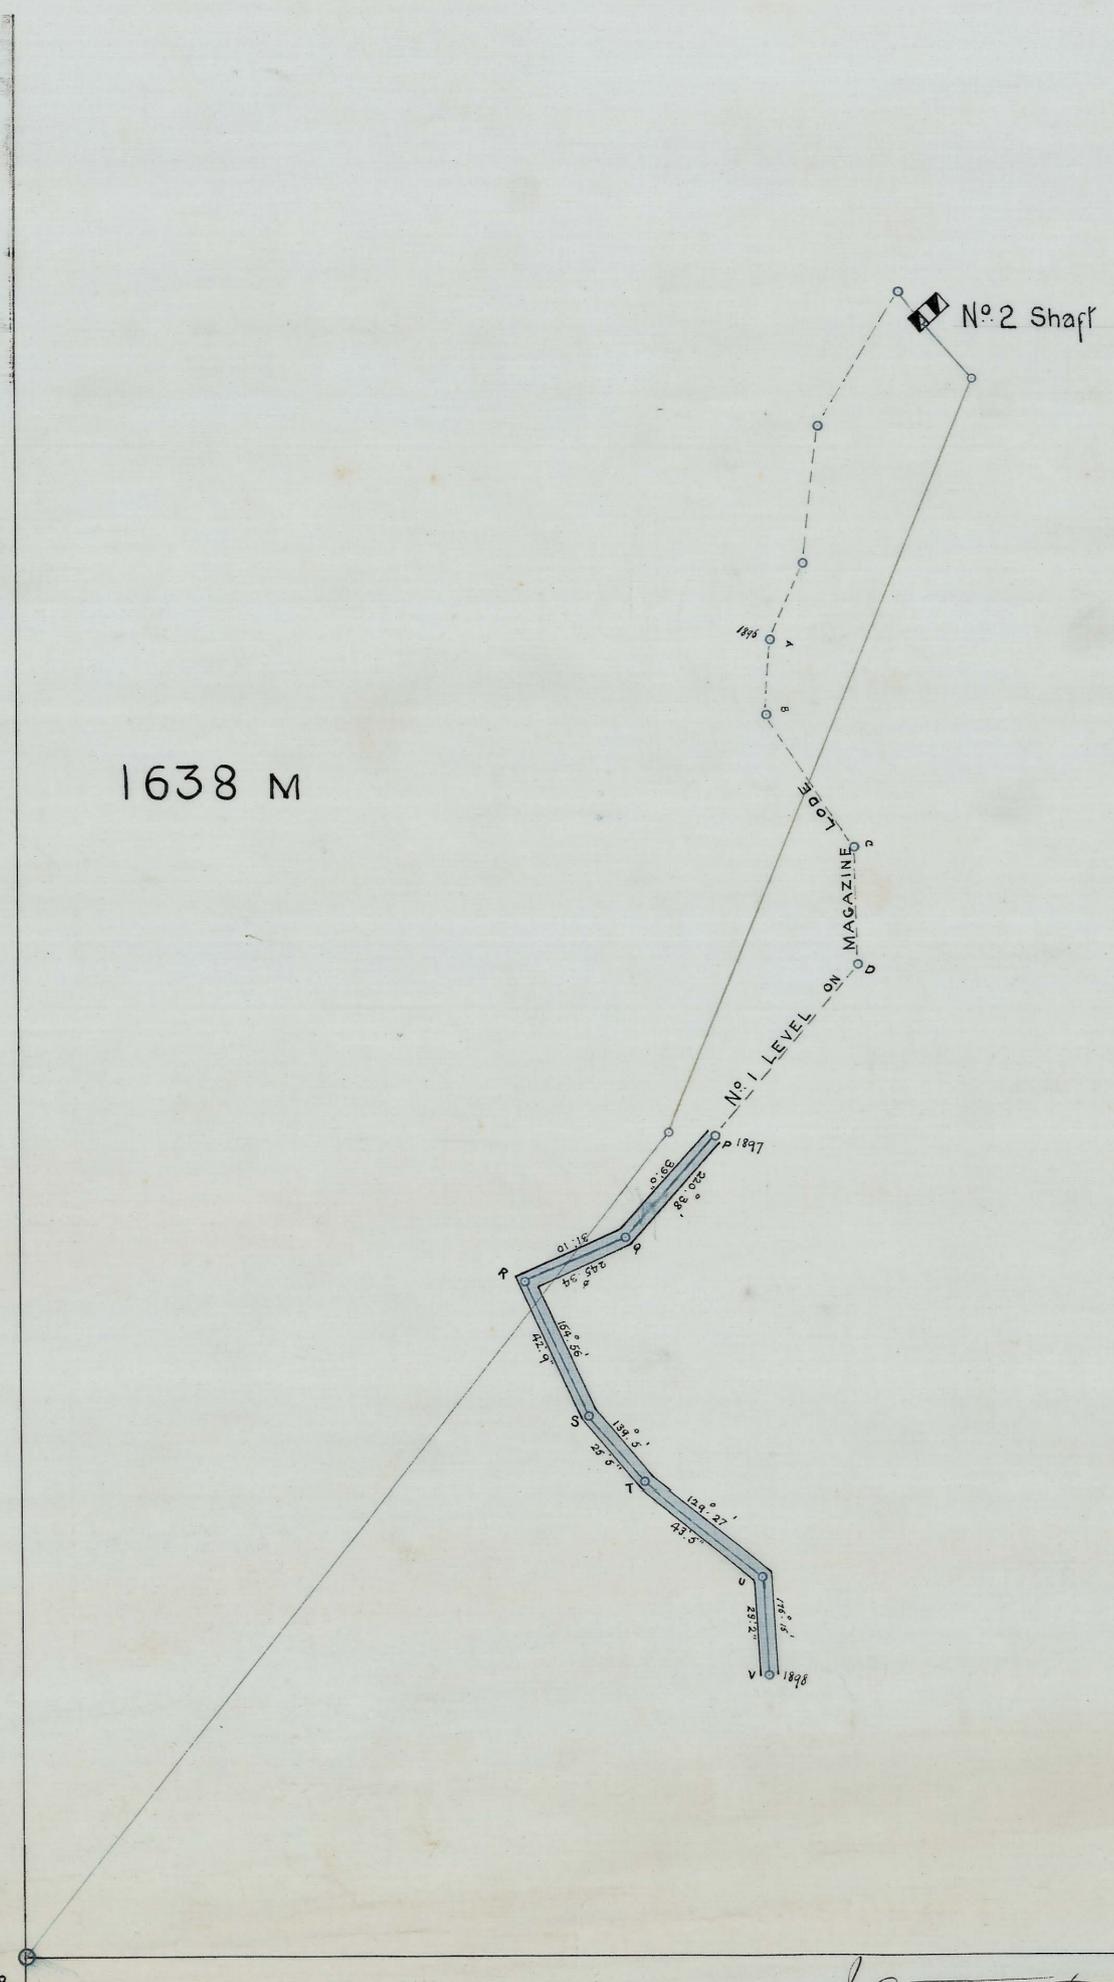

I Certify This Plan to be Correct
 Instruments used 3" Transit theodolite
 Steph. Richards
 Mining Engineer
 14.1.99