

SILVER QUEEN P.A.M.L.


(555)

— Transverse Section —

— Looking North —

— Main N° 4 and Clarkes Lodes —

— Scale 30 ft to 1 inch —

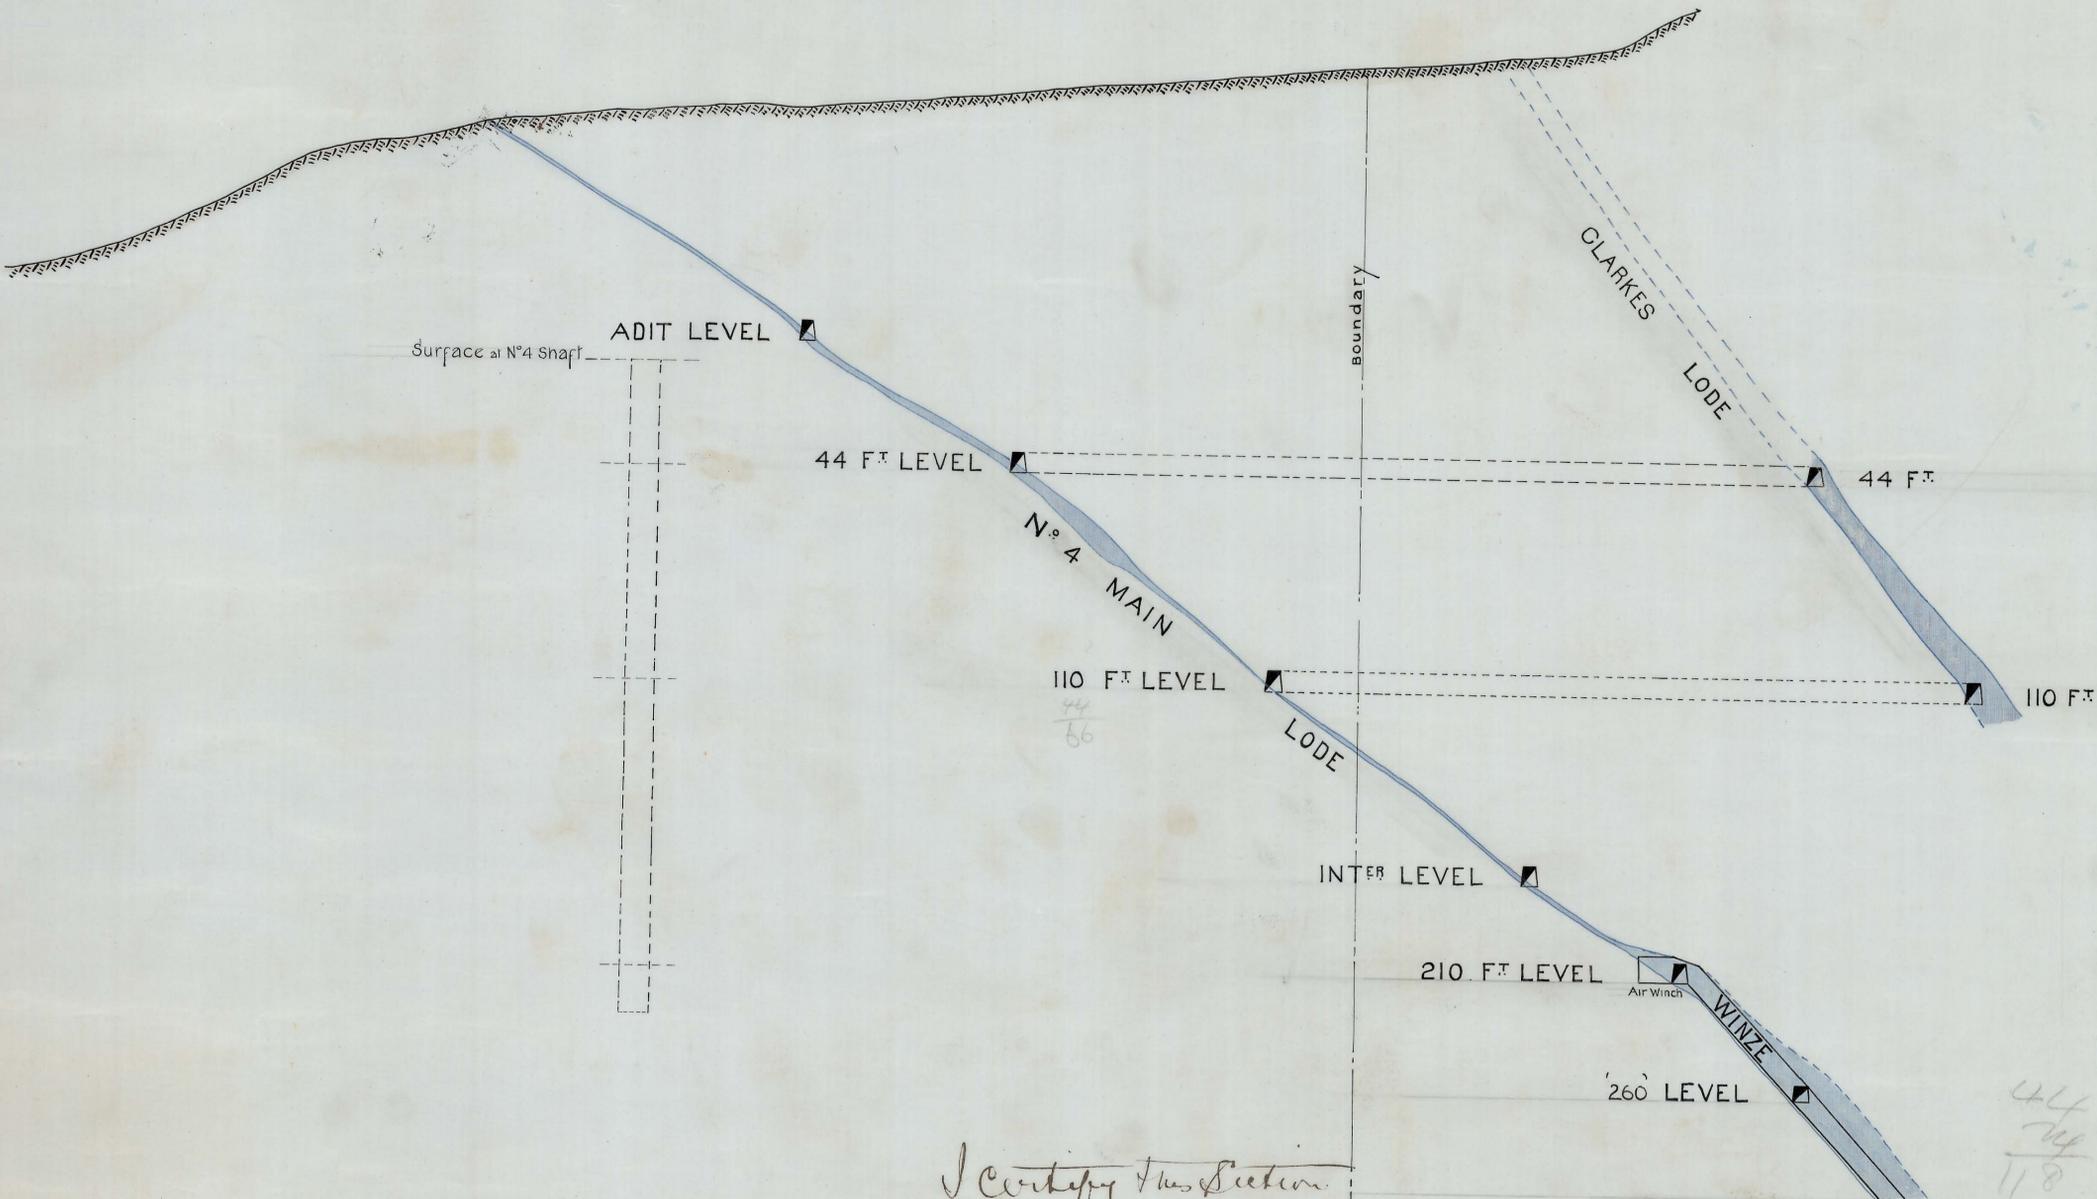

I Certify this Section
to be correct

Steph. Richards
Mining Manager

14-1-1899

