



SILVER QUEEN P.A.M.L.

— N° 5 WORKINGS —

Scale 30 Ft 1 Inch

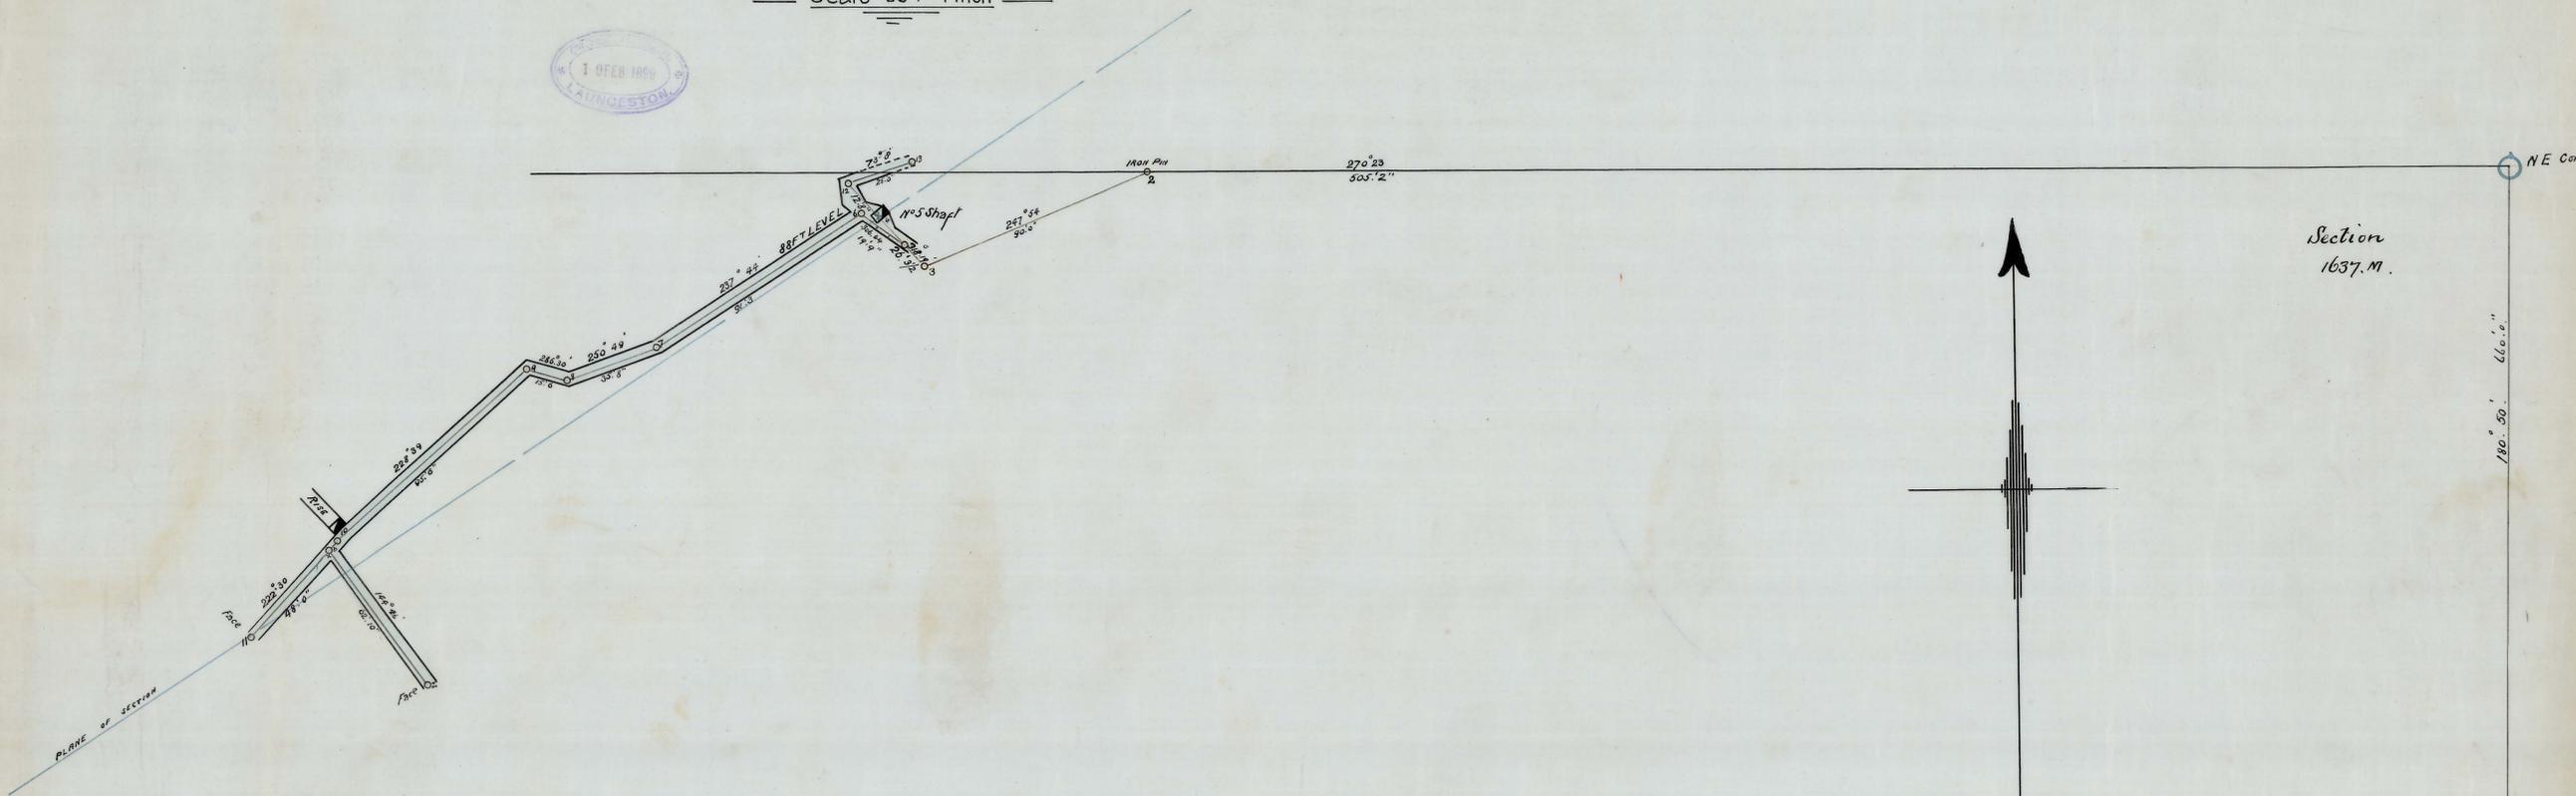

— Section —

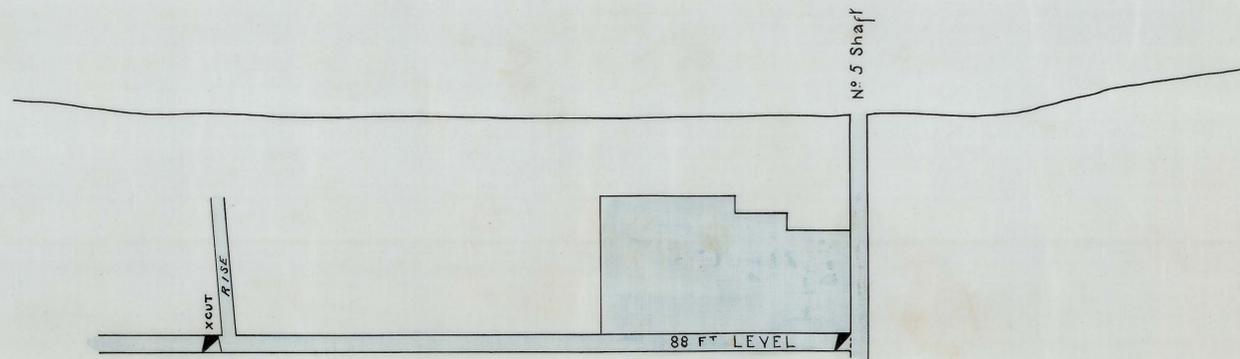

225-21

5 cm

180° 50' 46.1"