



223-22


SILVER QUEEN P. A. N. L.

Longitudinal Section
on
Clarke's Lode

Scale 30 ft to 1 inch

S

N

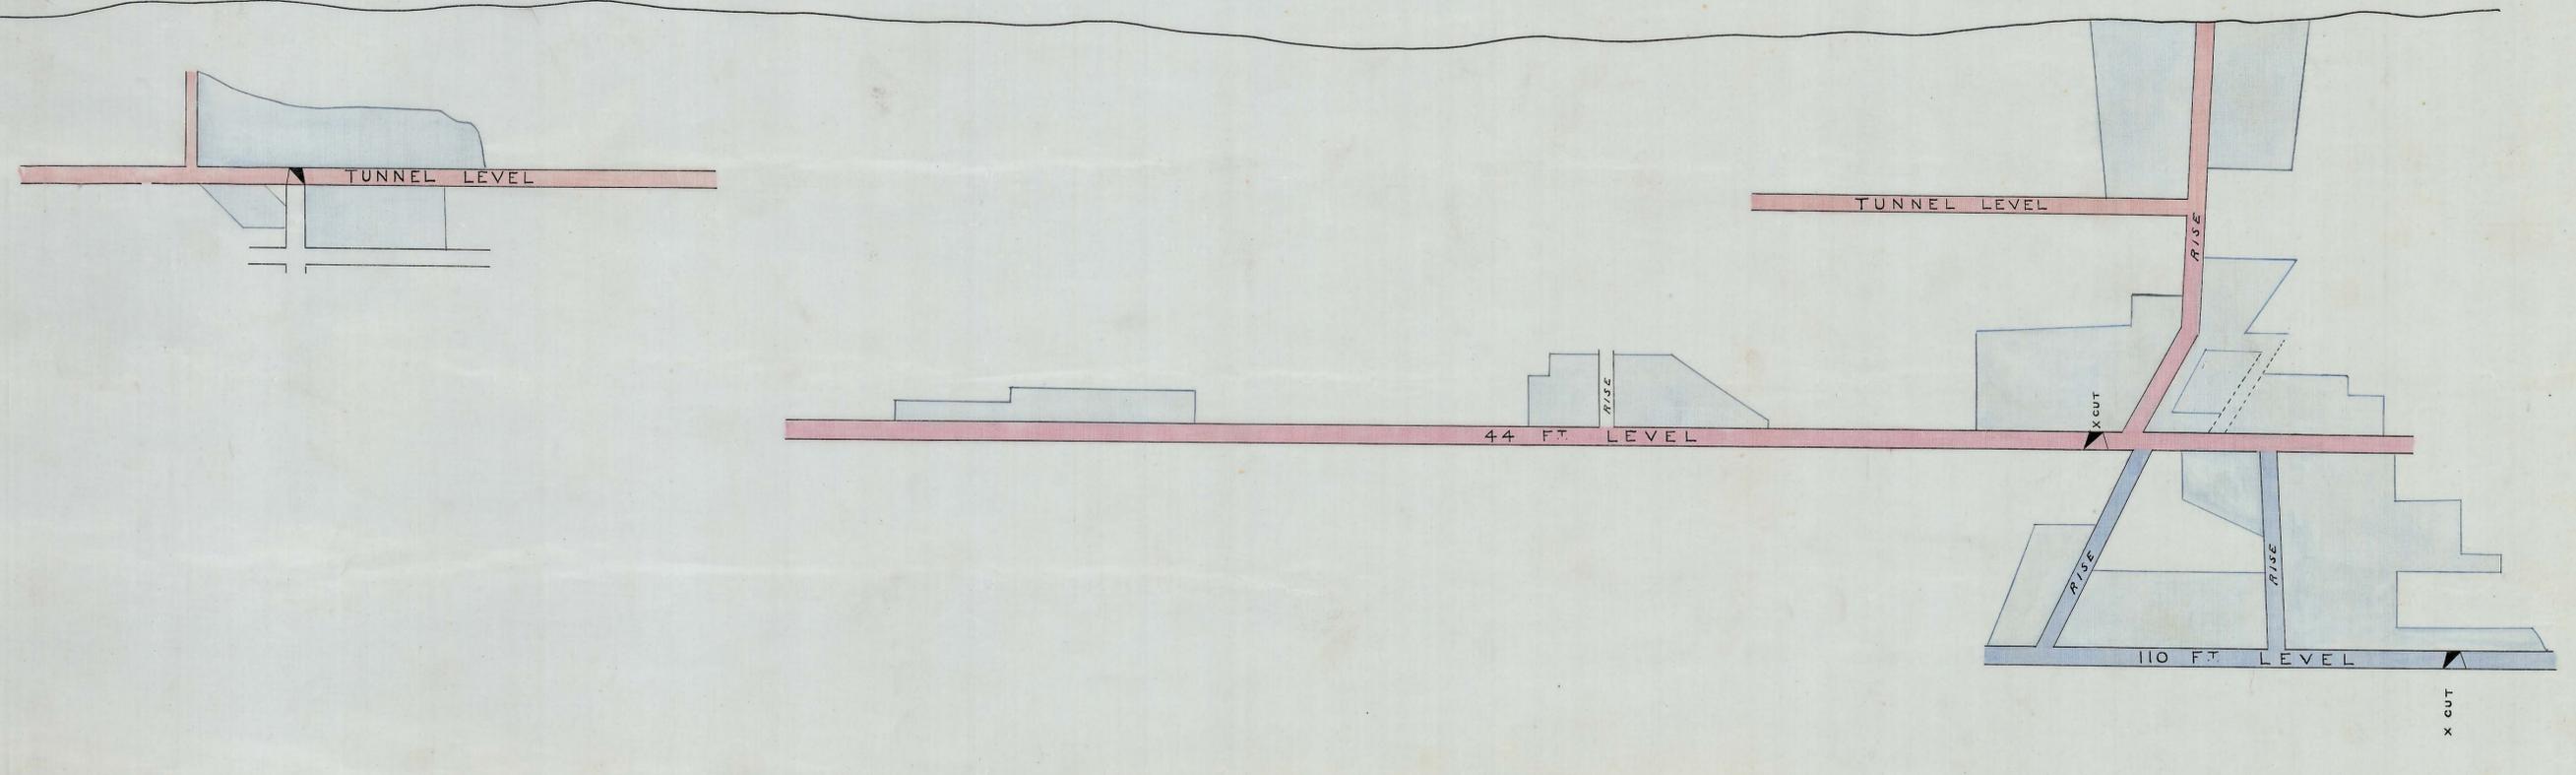

□ Stopping done to December 31st 1899.

*Section through sections
to the corner
of the P.A.N.L.
on map*

