


Longitudinal Section
on
N^o 4 Main Lode

SILVER QUEEN P. A. M. L.

— N^o 4 WORKINGS —

— Scale 30 ft to 1 inch —

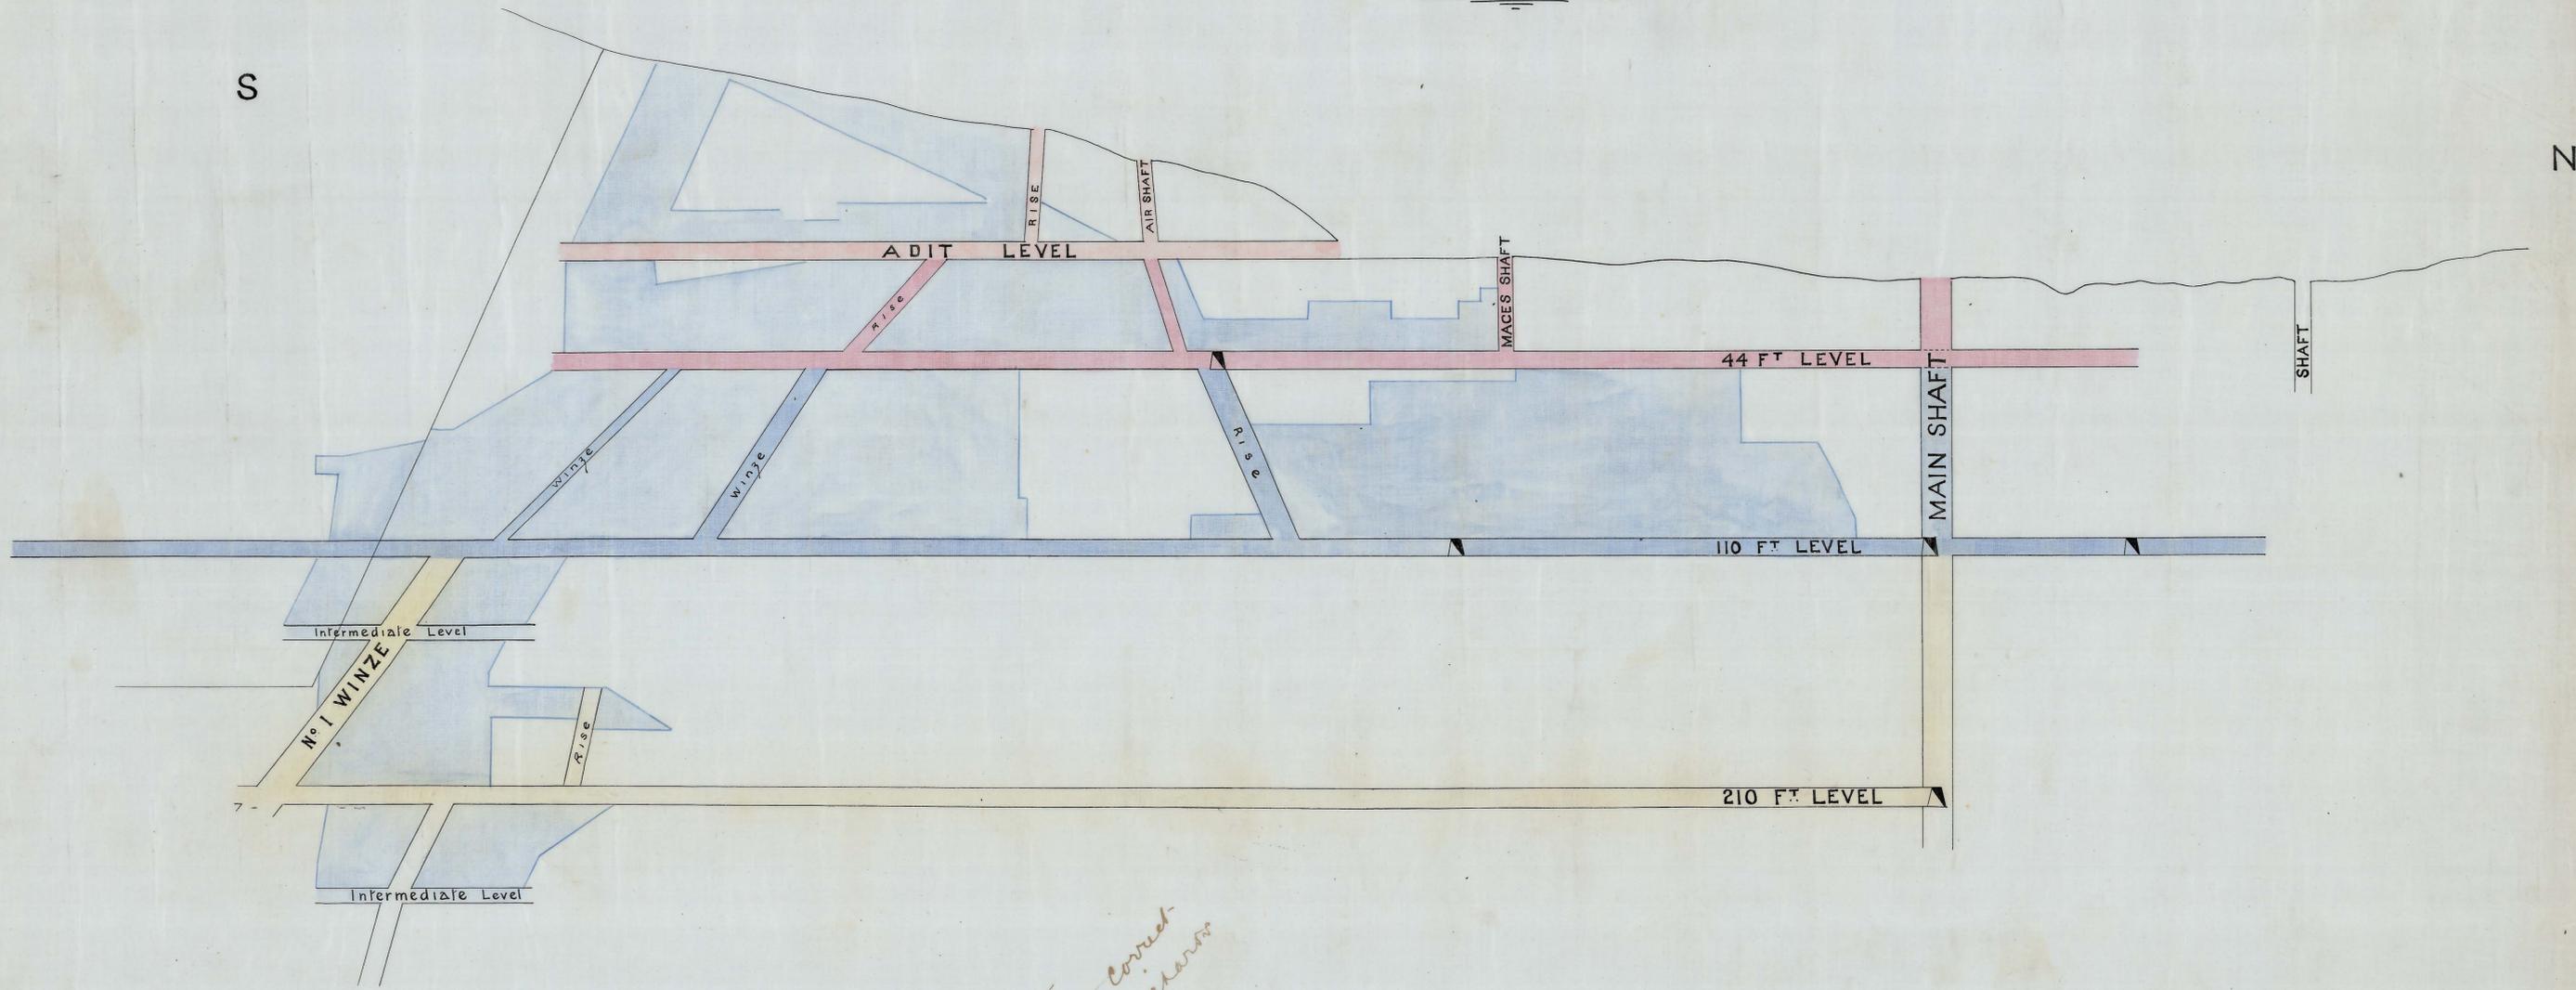

*Verify this section to be correct
Stop Richardson
in info*

Reference
Stopping down to December 31st 1899

225-23

225-23

51