

51

— Longitudinal Section —
— on —
— N^o 4 Main Lode —

— SILVER QUEEN P. A. N. L. —

— N^o 4 WORKINGS —

— Scale 30 ft to 1 inch —

5 cm


223-24

N

223-25
Top Lode

223-24

51

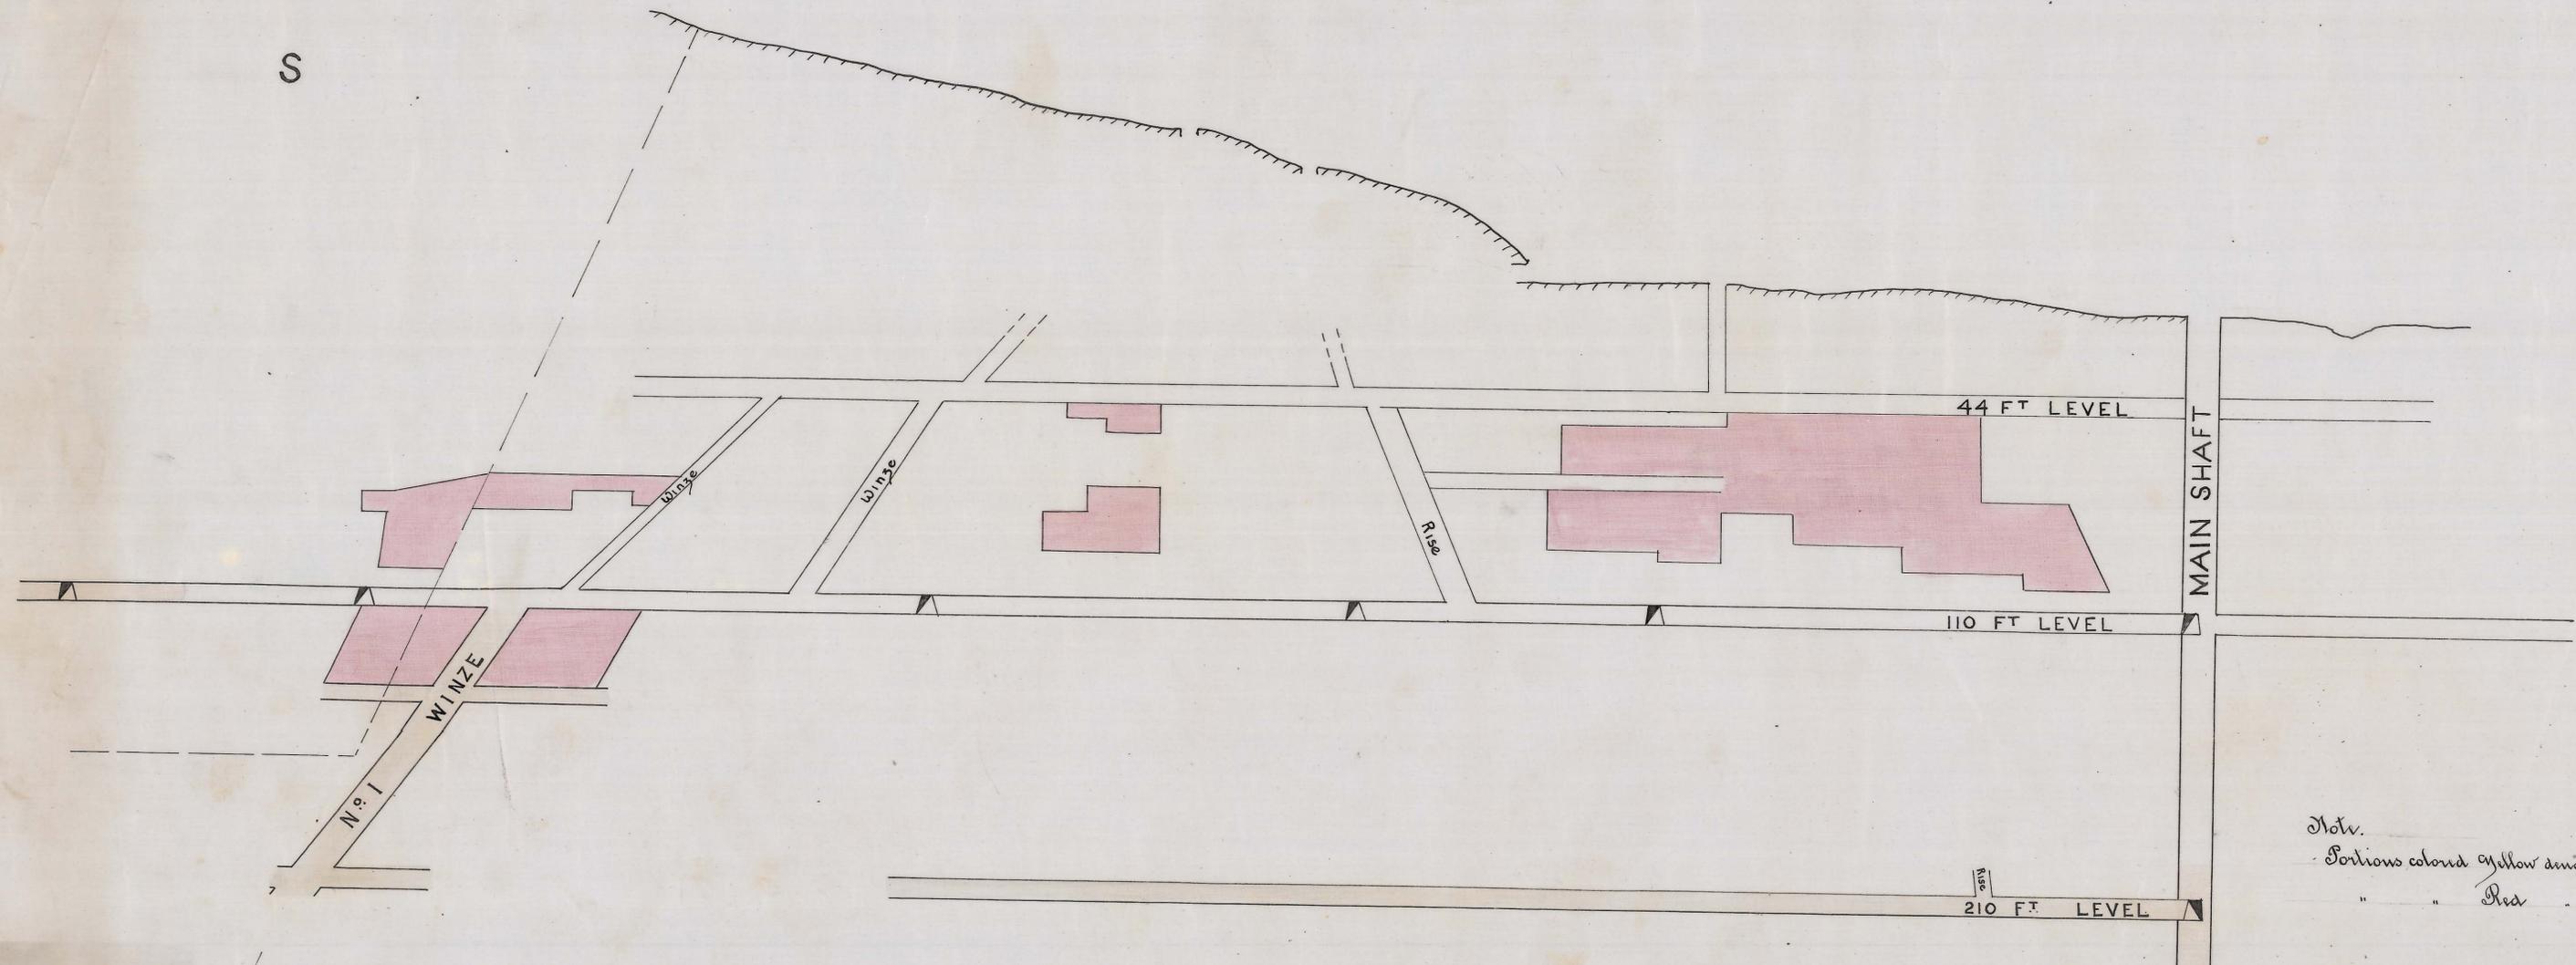

Note.
 Portions colored yellow denote sinking rising + driving done for year 1897
 " " Red " Stopping " " " "

SJB

51