




SECTION A.B.  
on  
N° 6 Lode

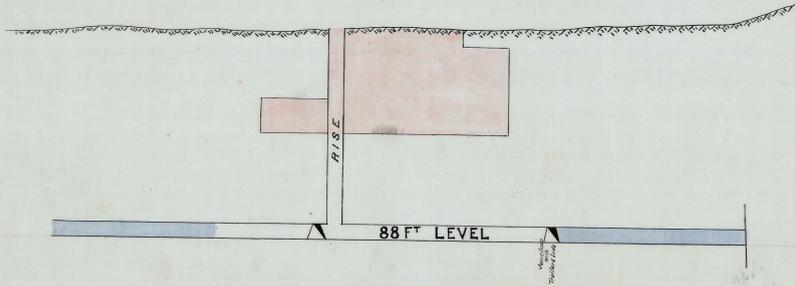


SECTION C.D.  
on  
N° 4 Lode

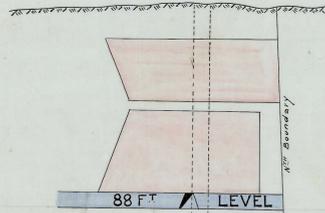


SECTION E.F.  
on  
Trotters Lode

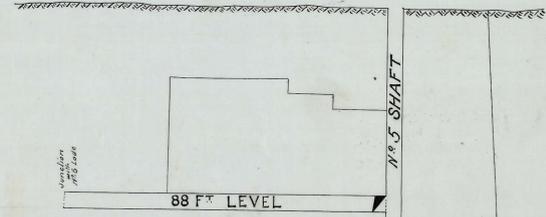

*Verify these  
Sections with  
Steph Richards  
in 1898*

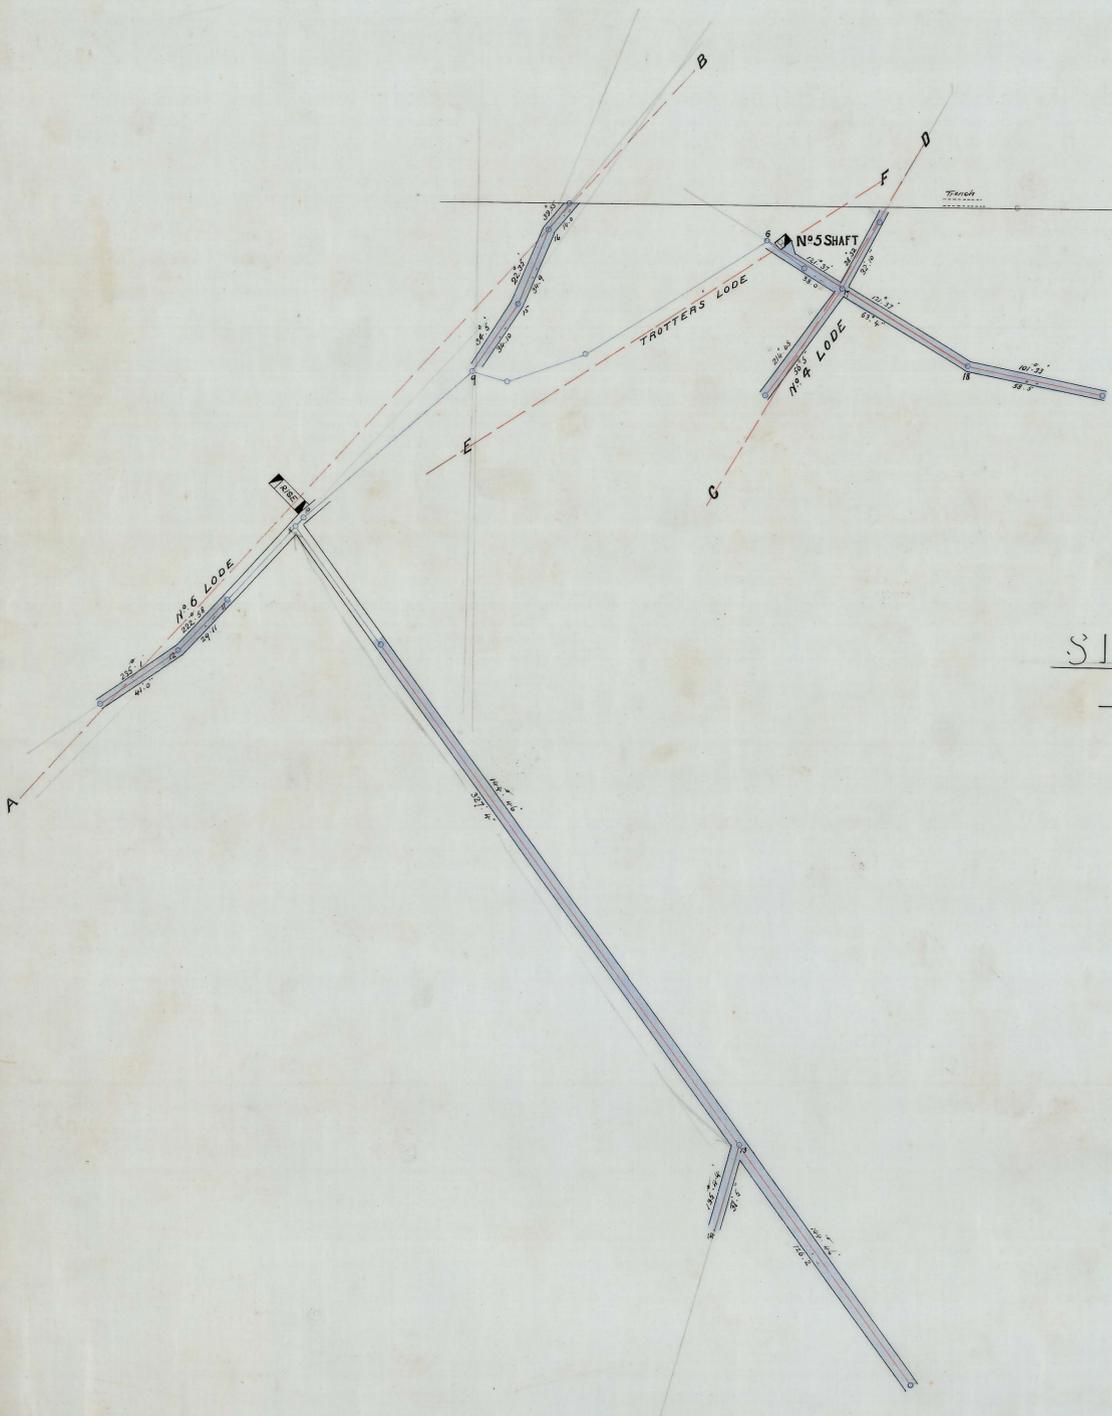

SILVER QUEEN P.A.N.L.  
— N° 5 WORKINGS —  
— Scale 30 ft to 1 inch —

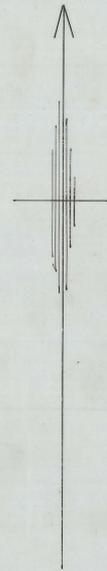

*Verify this plan  
with  
Steph Richards  
in 1898*

1591

15

223-26

223-26



51