

SILVER QUEEN P.A.


- Longitudinal Section on Clarkes Lode -

Scale 30ft 1 inch

*Wm. H. Bennett  
167 West  
3/12/1900*



223-27

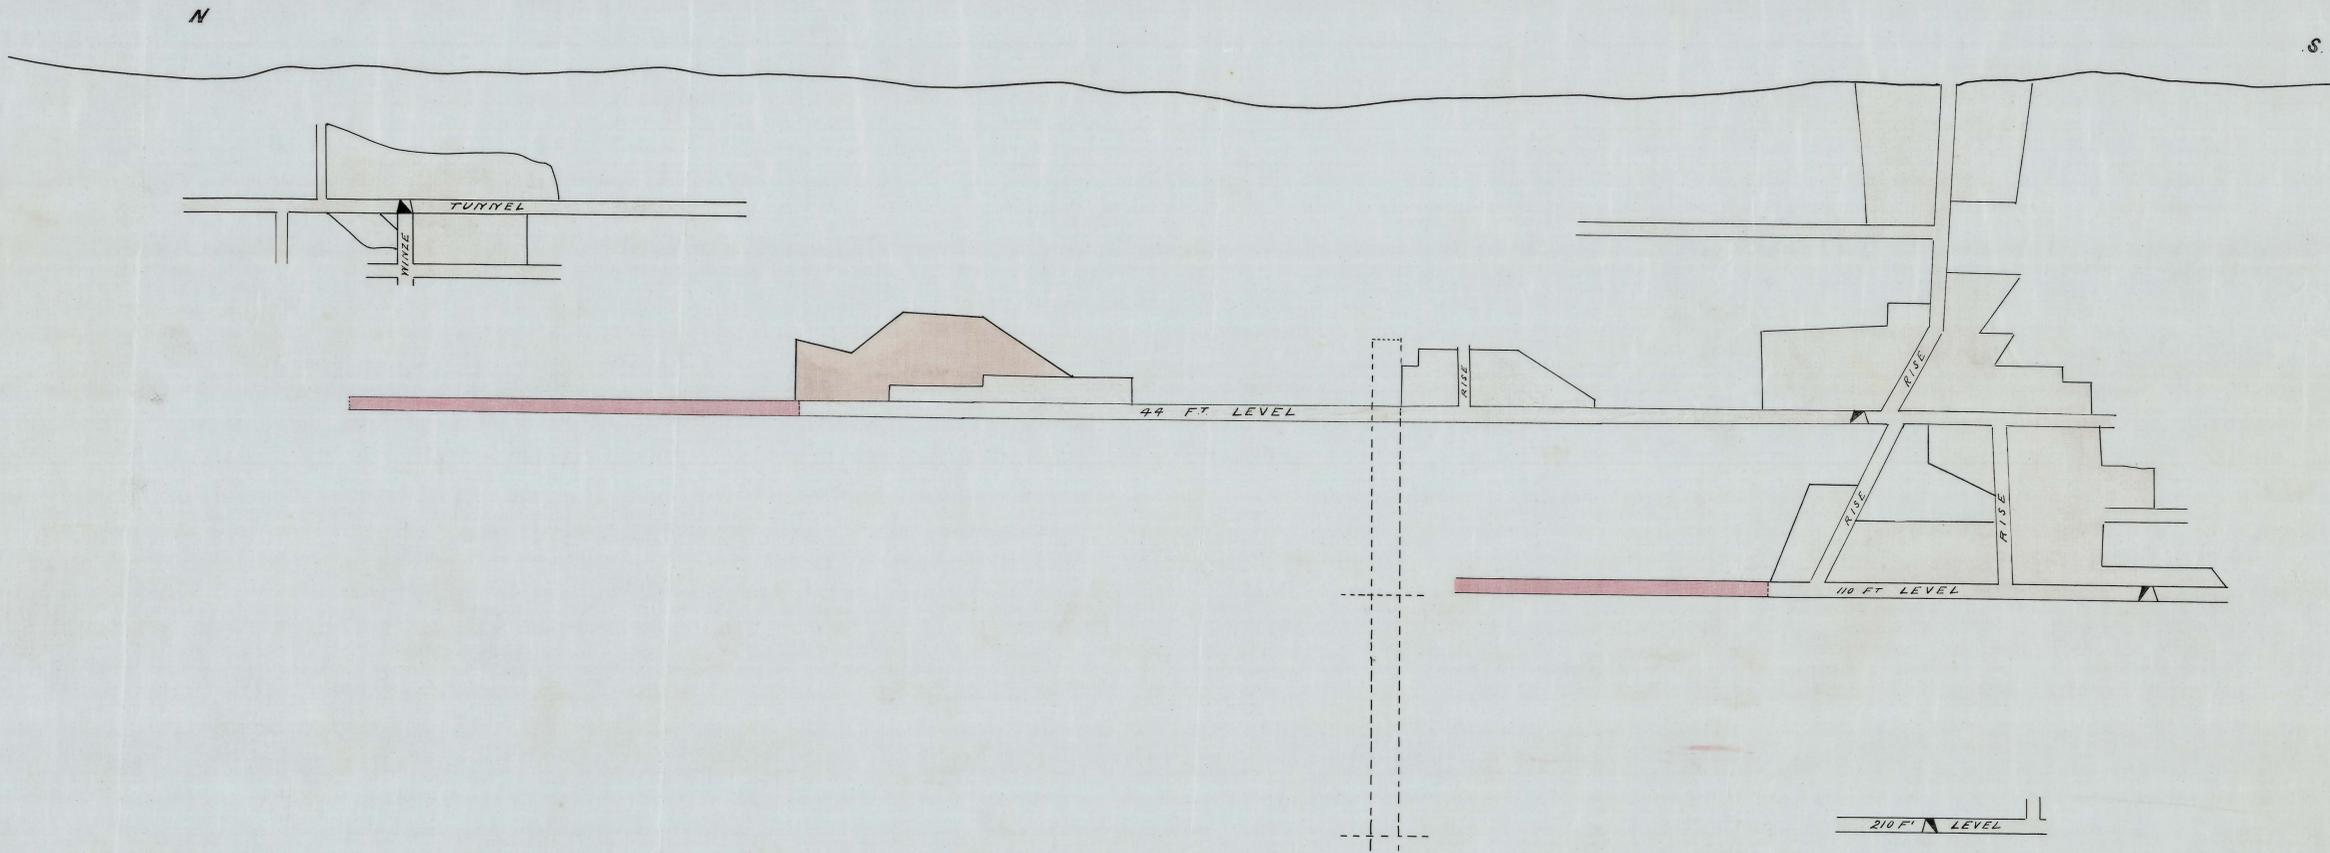

- old work
- Drilling done from 3/12/99 to 3/12/1900
- Stopping " " 3/12/99 to 3/12/1900.



223-27