

223-31

SILVER QUEEN P A NL

Nº 4 WORKINGS

Scale 30 ft to 1 inch




Longitudinal Section
on
Clarke's Lode



N S

N S

SURFACE LINE ON LOPE

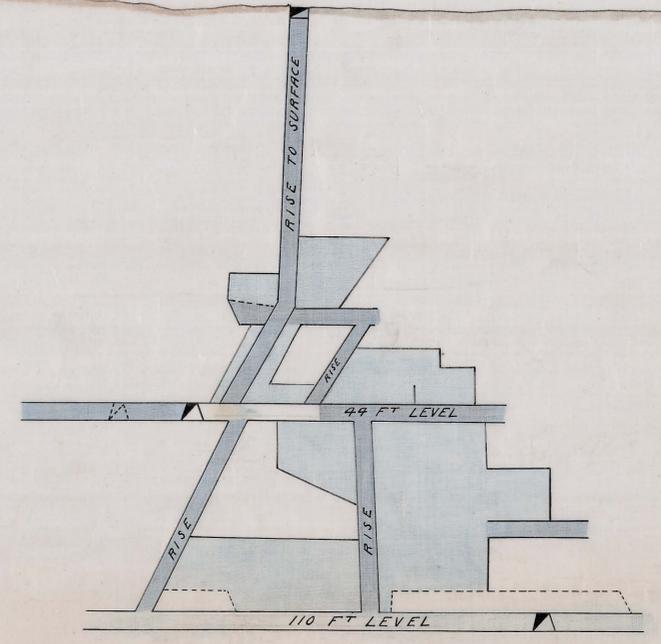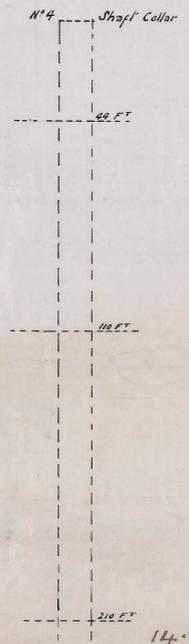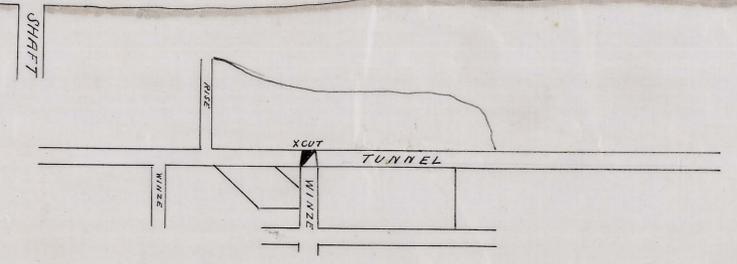

- Work done Driving and Raising for year ending December 1898
- Do Do Stopping " " " "

5 cm

I certify this Section
 to be correct
 Stephen Richards
 Mining Manager
 14.1.1899