



1665m Mr Zeehan (Tas) 40 acres.

MARSH'S TRIBUTE

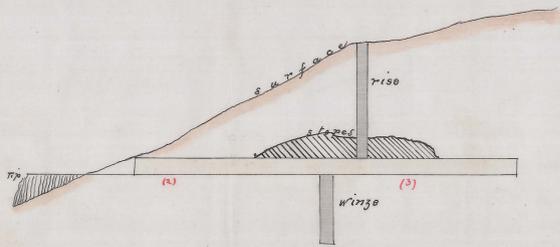


187m Silver Queen Extended 76 ac

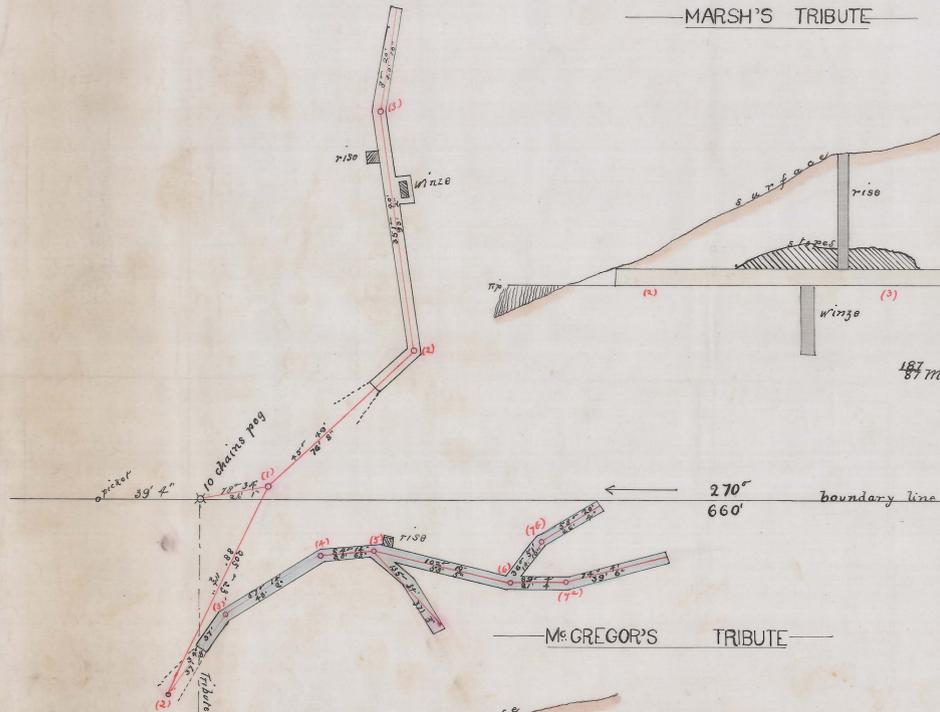

MR. GREGOR'S TRIBUTE

188m Silver Queen Extended 80 acres.

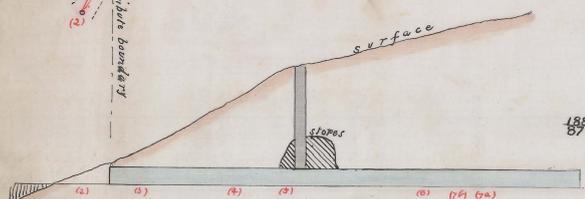

187m Mr Zeehan (Tas) 80 acres.

George A. Waller
M. Am. & M. E.
Jan. 26. 98.



221-01

221-01

111
8081