

224-02


1665 M 40ac. Mt. Zeehan Tas. S. L. M. Co

224-02




PLAN OF WORKINGS SILVER QUEEN EXTENDED TRIBUTE

Scale 25 feet to 1 inch

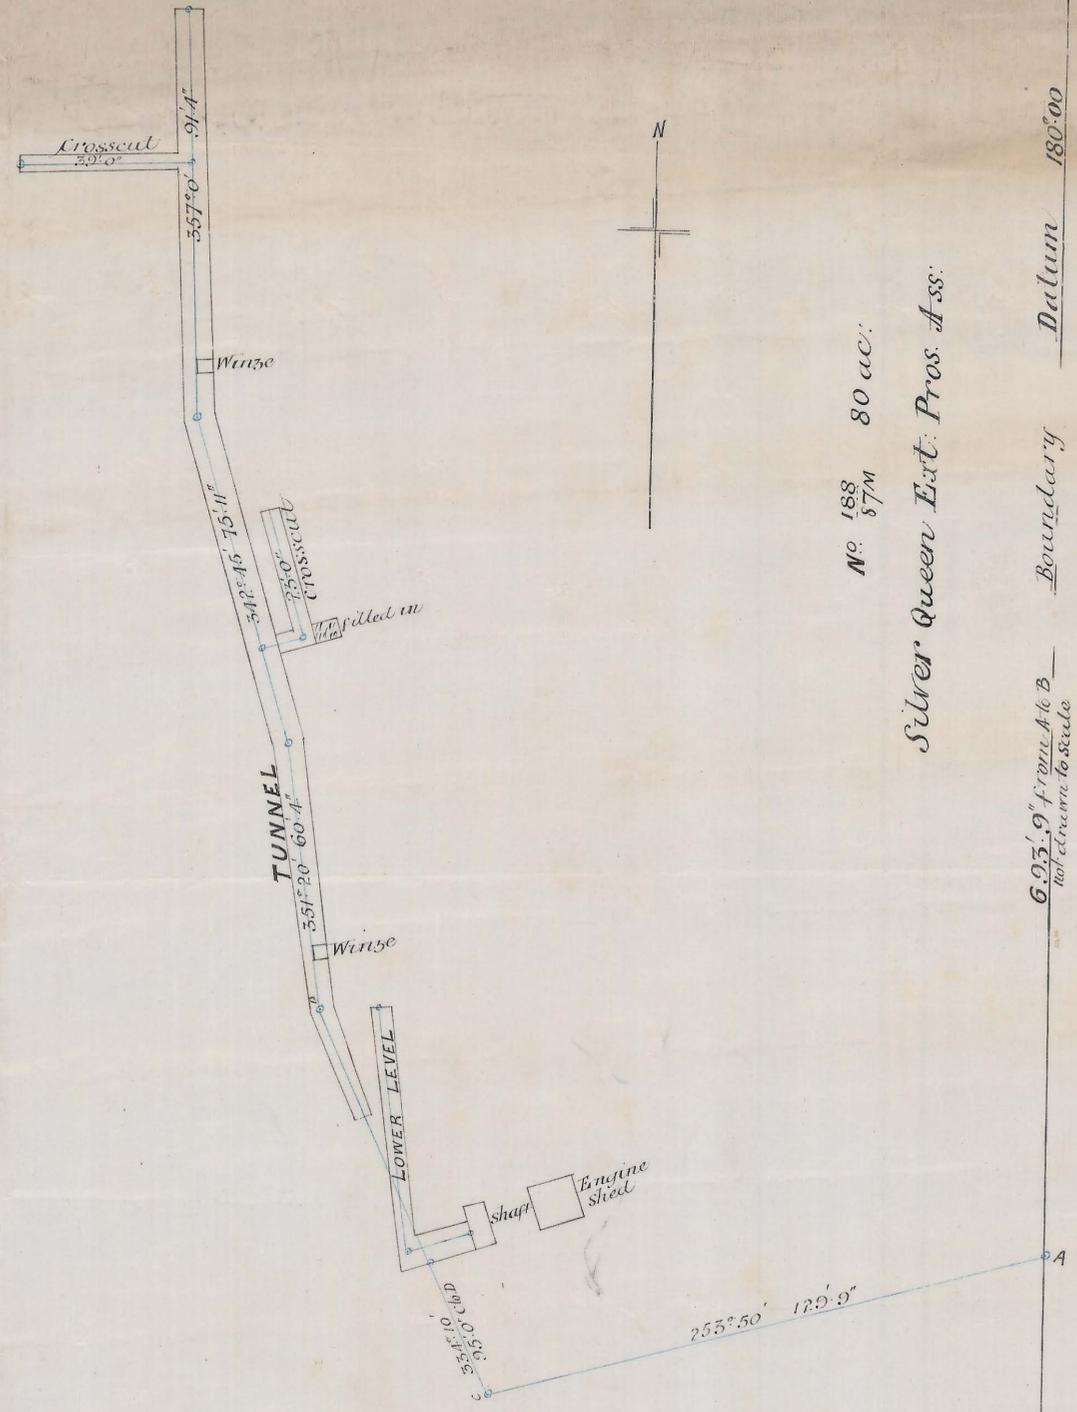

SECTION

Scale. Horizontal 2 chns = 1 inch
" Vertical 20 feet = 1 inch

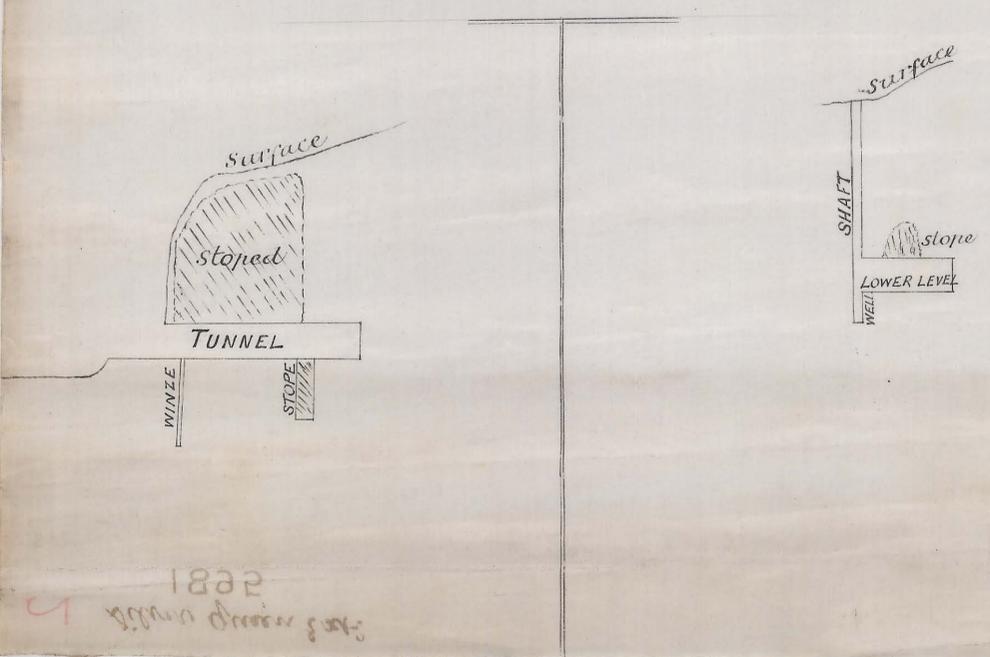

Mount Zeehan
Tas S. L. M. Co. No. 111a



E. J. Smith
Kinrossed Surveyor
Zeehan April 1895
Survey effected with J. G. Wolfe
E. J. Smith

1895
Start working on 1895