
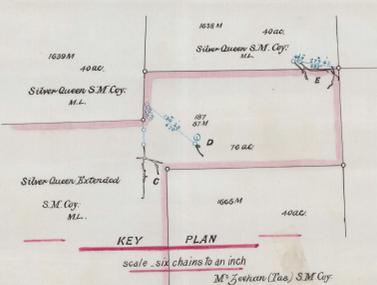


PLAN OF WORKINGS ON SILVER QUEEN EXTENDED

Scale
25 feet to an inch

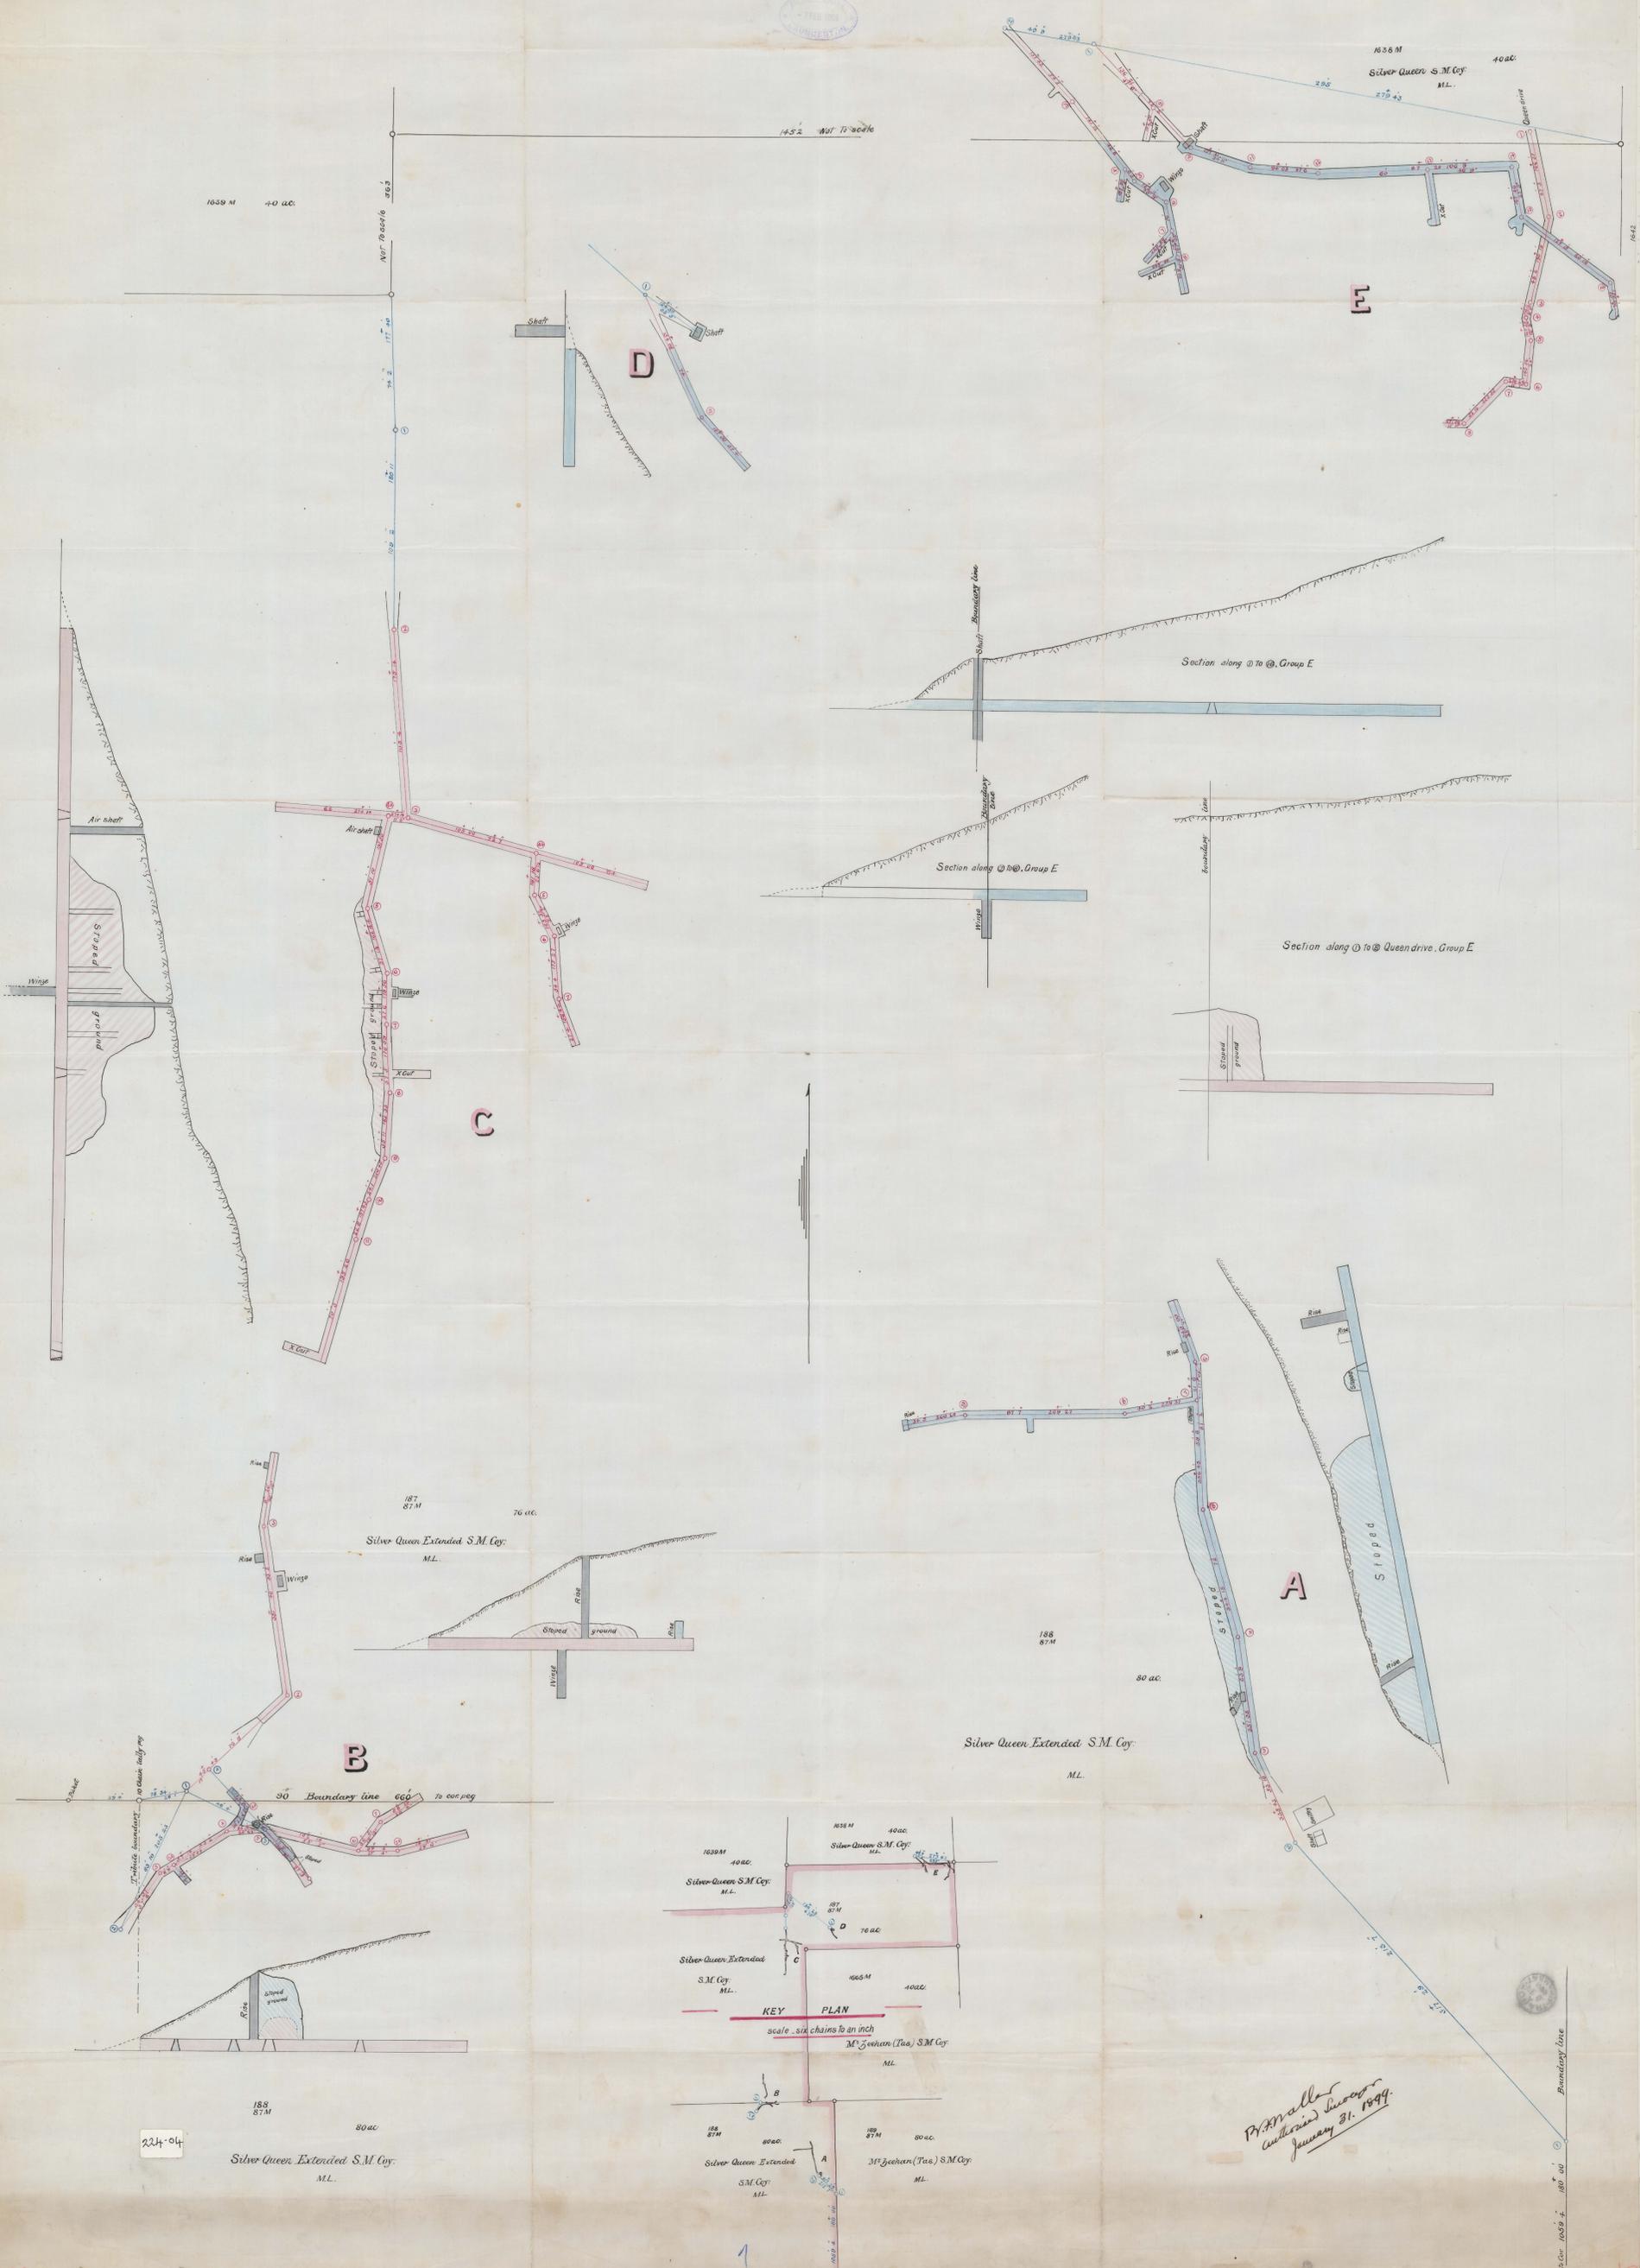

*P. H. Mallett
Cartographer
January 31, 1899.*

Silver Queen Extended

Silver Queen S.M. Coy.