

Silver Queen
1638 m 40 acres

Silver Queen
1639 m 40 acres

145' (22 chains) - not to scale

CLABBURN'S TRIBUTE
as worked by Queen Coy

FAHEY'S TRIBUTE

PLAN OF WORKINGS

ON

SILVER QUEEN EXTENDED

Silver Queen

1642 m

50-1100

Clabburn's
not to scale



Scale 25 feet to an inch.

George A. Waller
M. Am. & M. E.
Jan 26 '98

360°
1320' (20 chains) - not to scale

1320' - not to scale

(0)
(1)
(2)
(3)
(4)
(5)
(6)
(7)
(8)
(9)
(10)

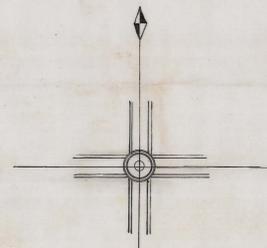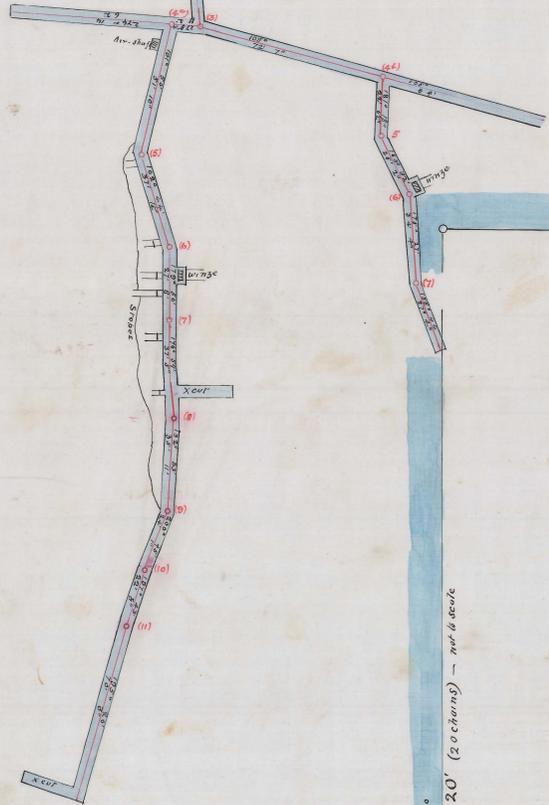

221-05

221-05
Top
Layer

5