


UNDERGROUND WORKINGS

SILVER QUEEN EXT'D MINE

SECTION 187 87 M

SCALE . 25 FEET TO 1 INCH

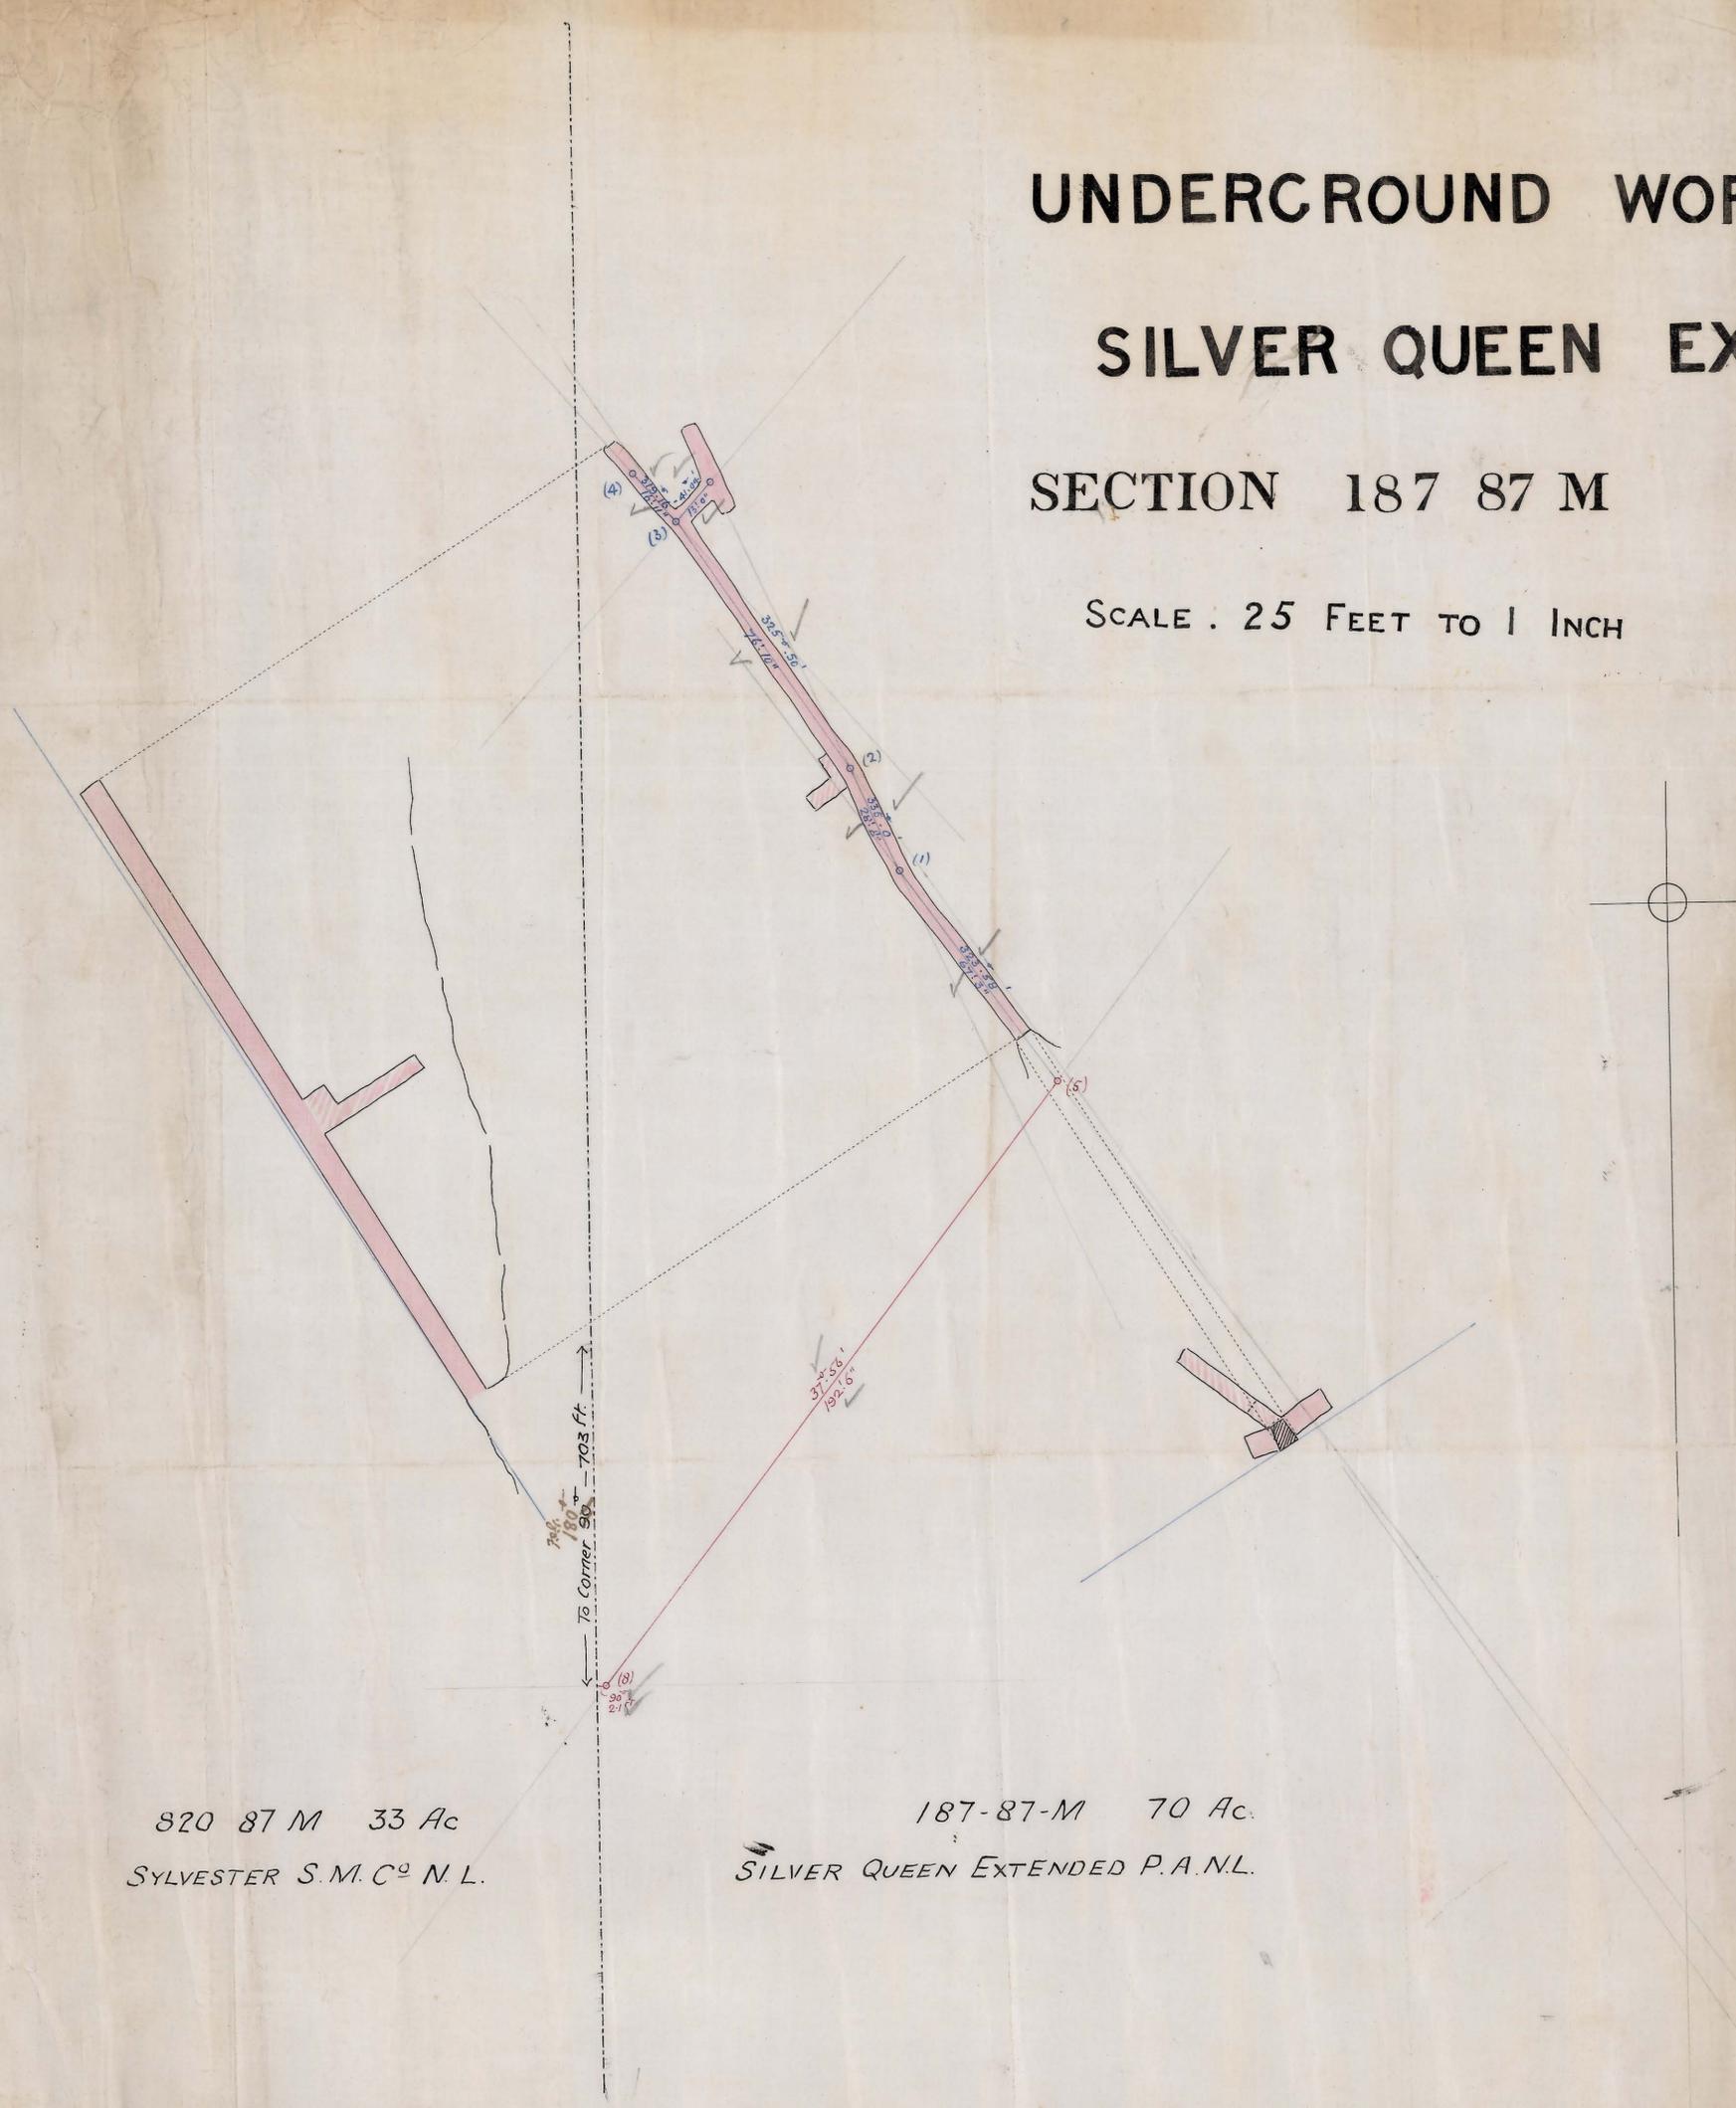

224-06



820 87 M 33 Ac
SYLVESTER S.M.C. N.L.

187-87-M 70 Ac.
SILVER QUEEN EXTENDED P.A.N.L.

R. Malle
Authentic Surveyor
Feb 2-1900

101
Aug 10-10-10
P.M. 101
Aug 10-10-10
P.M. 101

101

224-06

224-07
Top Layer