





Notes: Work done year ending 31/12/1900 below the
f. brags. Jan 31st 1901

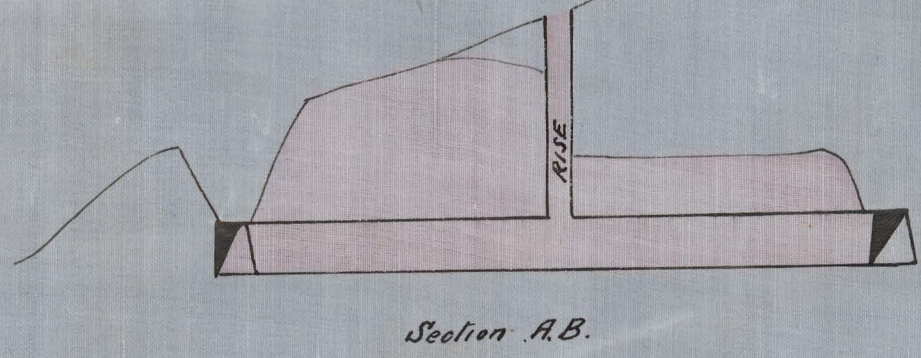

Shed 18/10/00

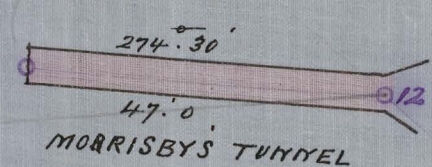

18/10/00


18/10/00

18/10/00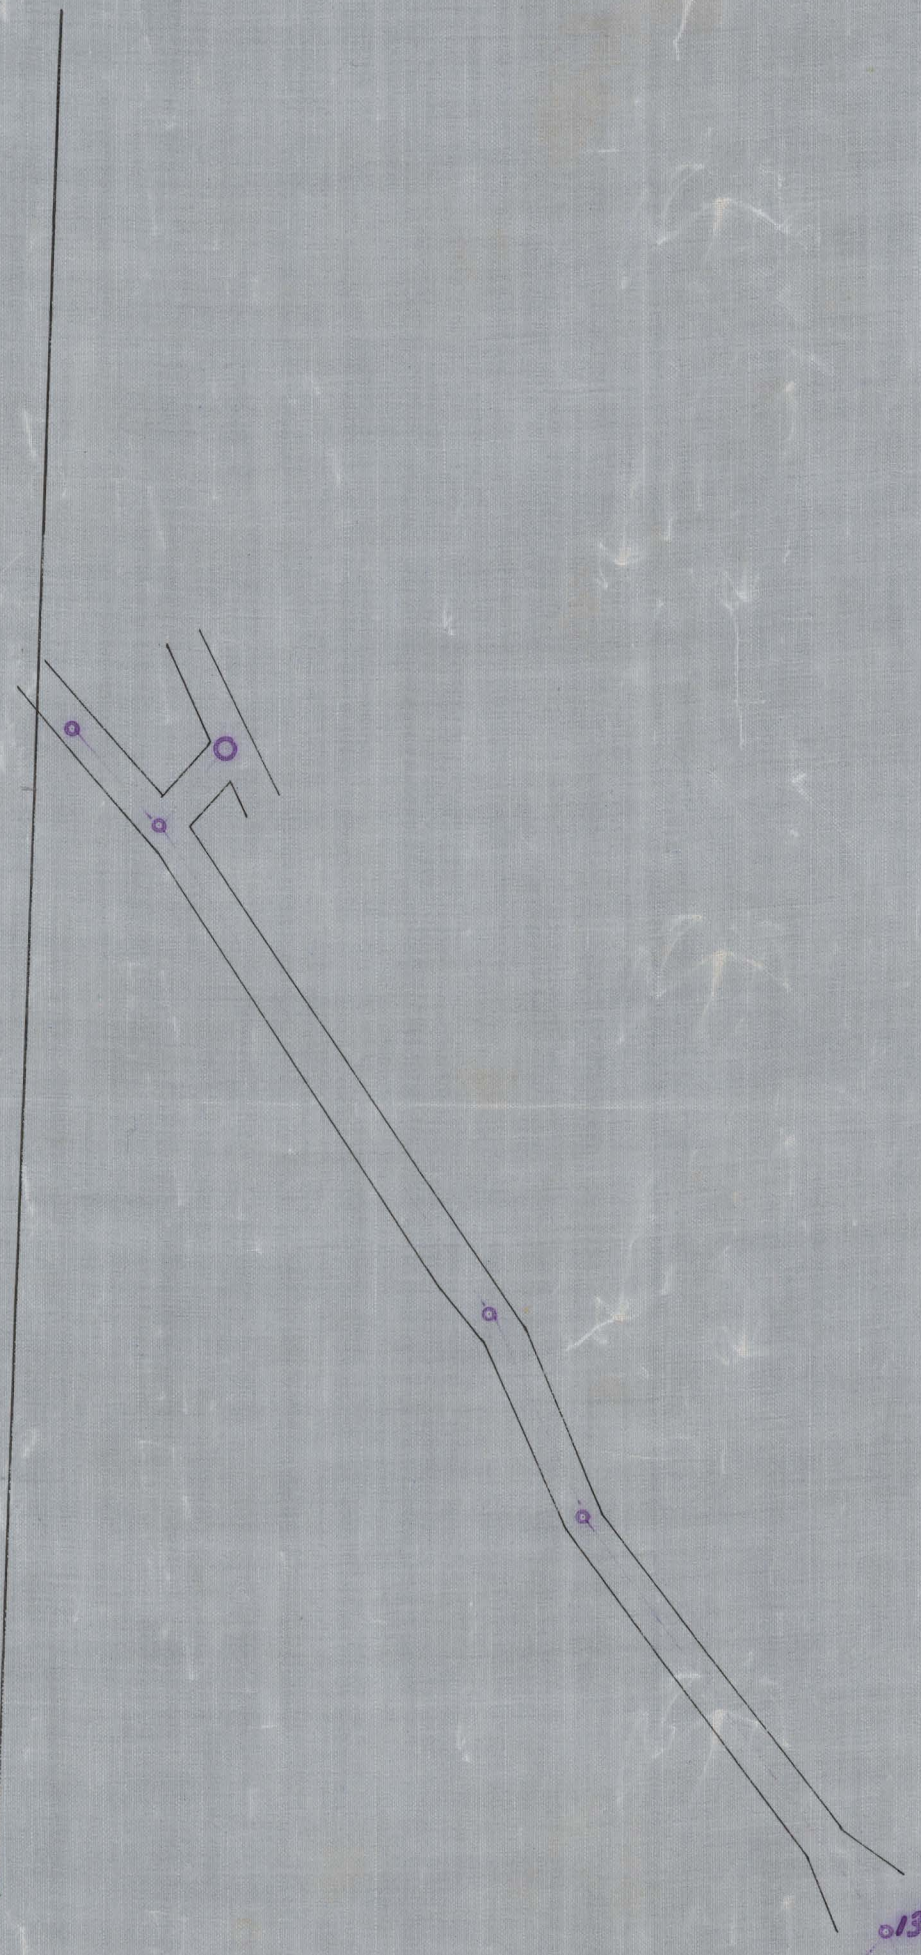

18/10/00 70 AC

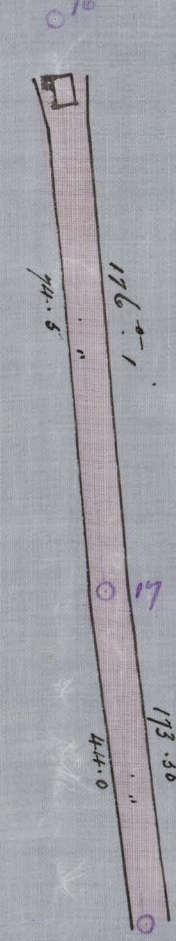

18/10/00

18/10/00