

224-09

5 cm


224-09

THE M^r ZEEHAN (TAS) S. L. MINES L^{TD}


QUEEN EXTENDED BLOCKS

Scale. 30 Feet to 1 Inch

SECTION ON LINE A.B

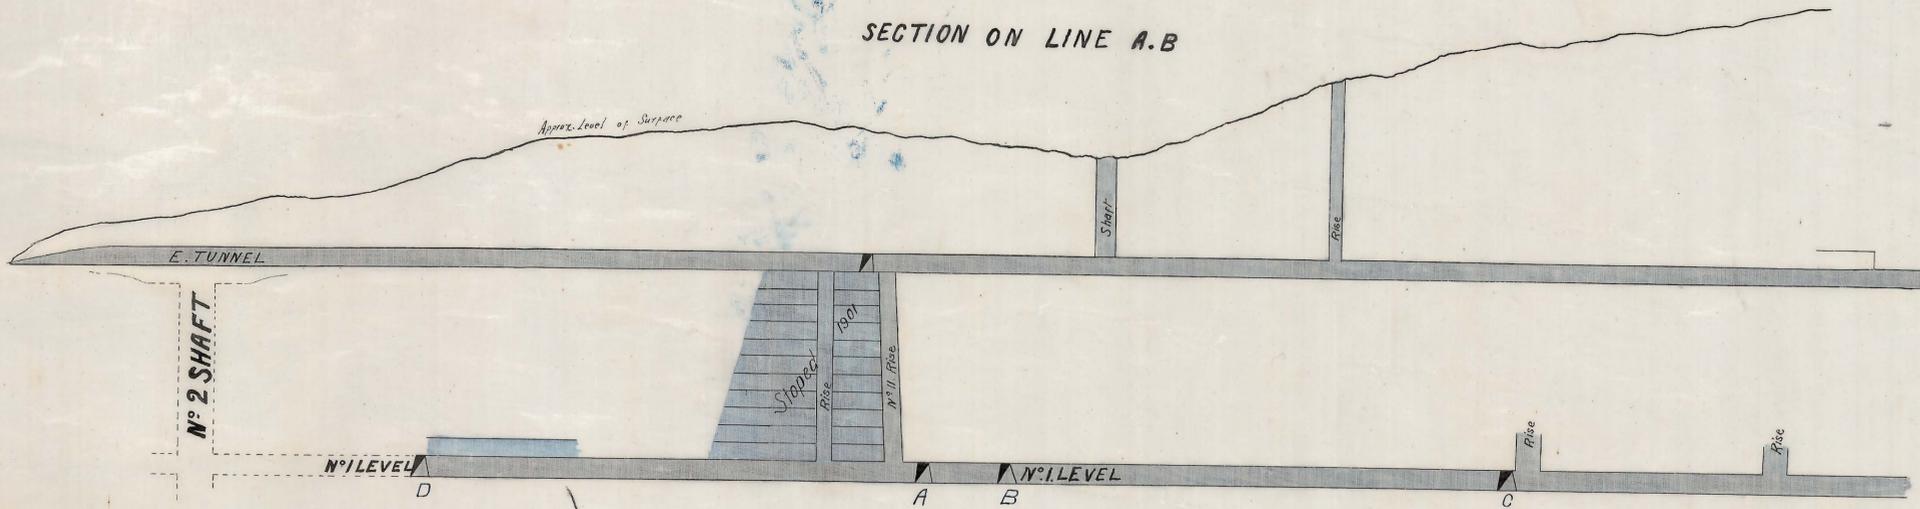

SECTION ON LINE C.D

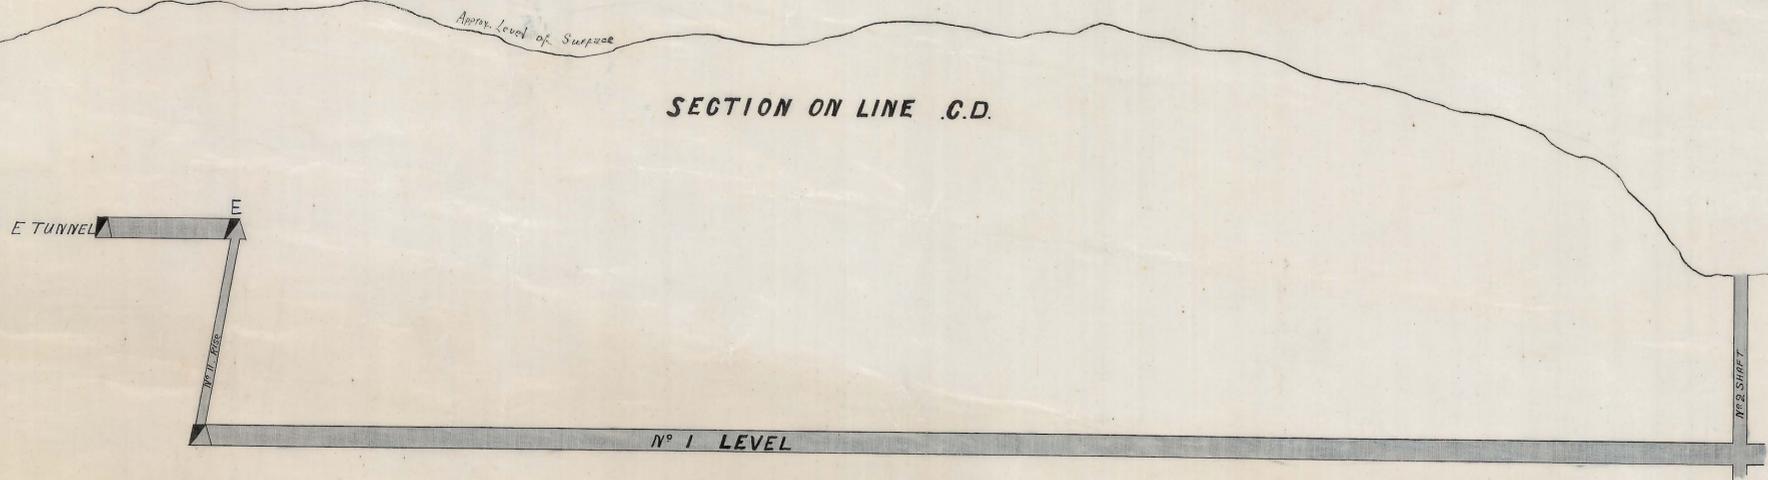

W. J. ...
MANAGER

10/2/78

Handwritten notes in the top right corner, including '224-09' and other illegible text.

2