

SECTION


M^r ZEEHAN(TAS) S. L. MINES L^d

QUEEN EXTENDED BLOCK 5


Scale 30 Feet to 1 inch.




N^o 12 Lode

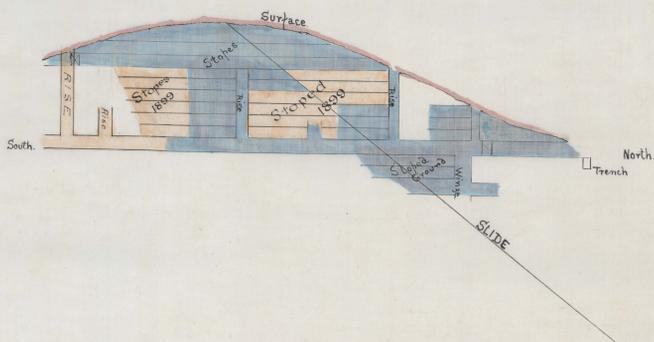

N^o 14 Lode

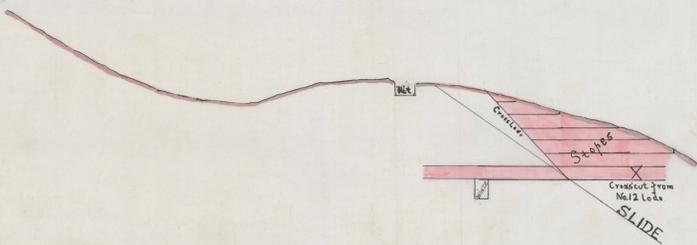

N^o 10 Lode

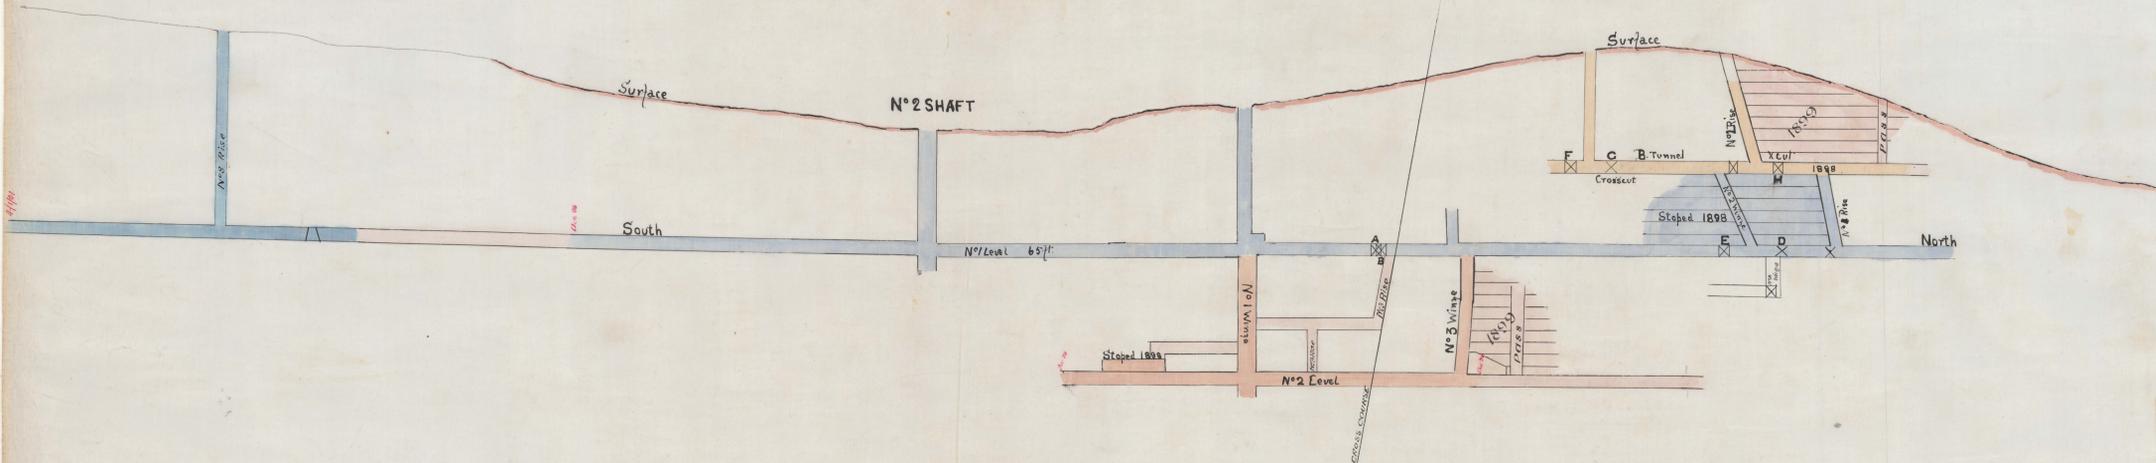

224/12