
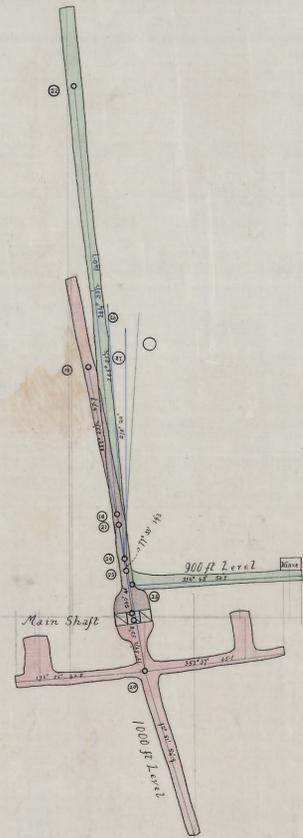


Corner Peg  
Actual Position

Corner Peg  
Paper Position

# Tasmanian Consols Mine Plans

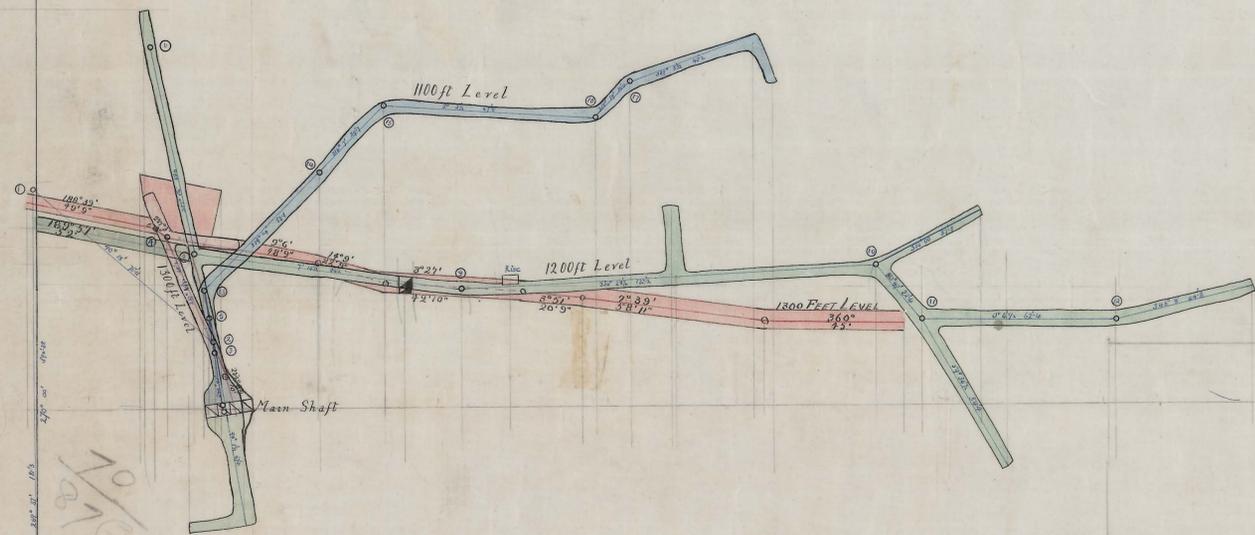

Scale  
1 in = 25 ft

New Golden Gate  
879  
13

N.G. Gate

1891  
1891  
Hardwell Conder

227-03

227-03

Hardwell Conder  
March 1904



T. W. ANDREWS.  
April 7 1905