


227-06
Tasmanian Consols

227-07
Tasmanian Consols

5 cm

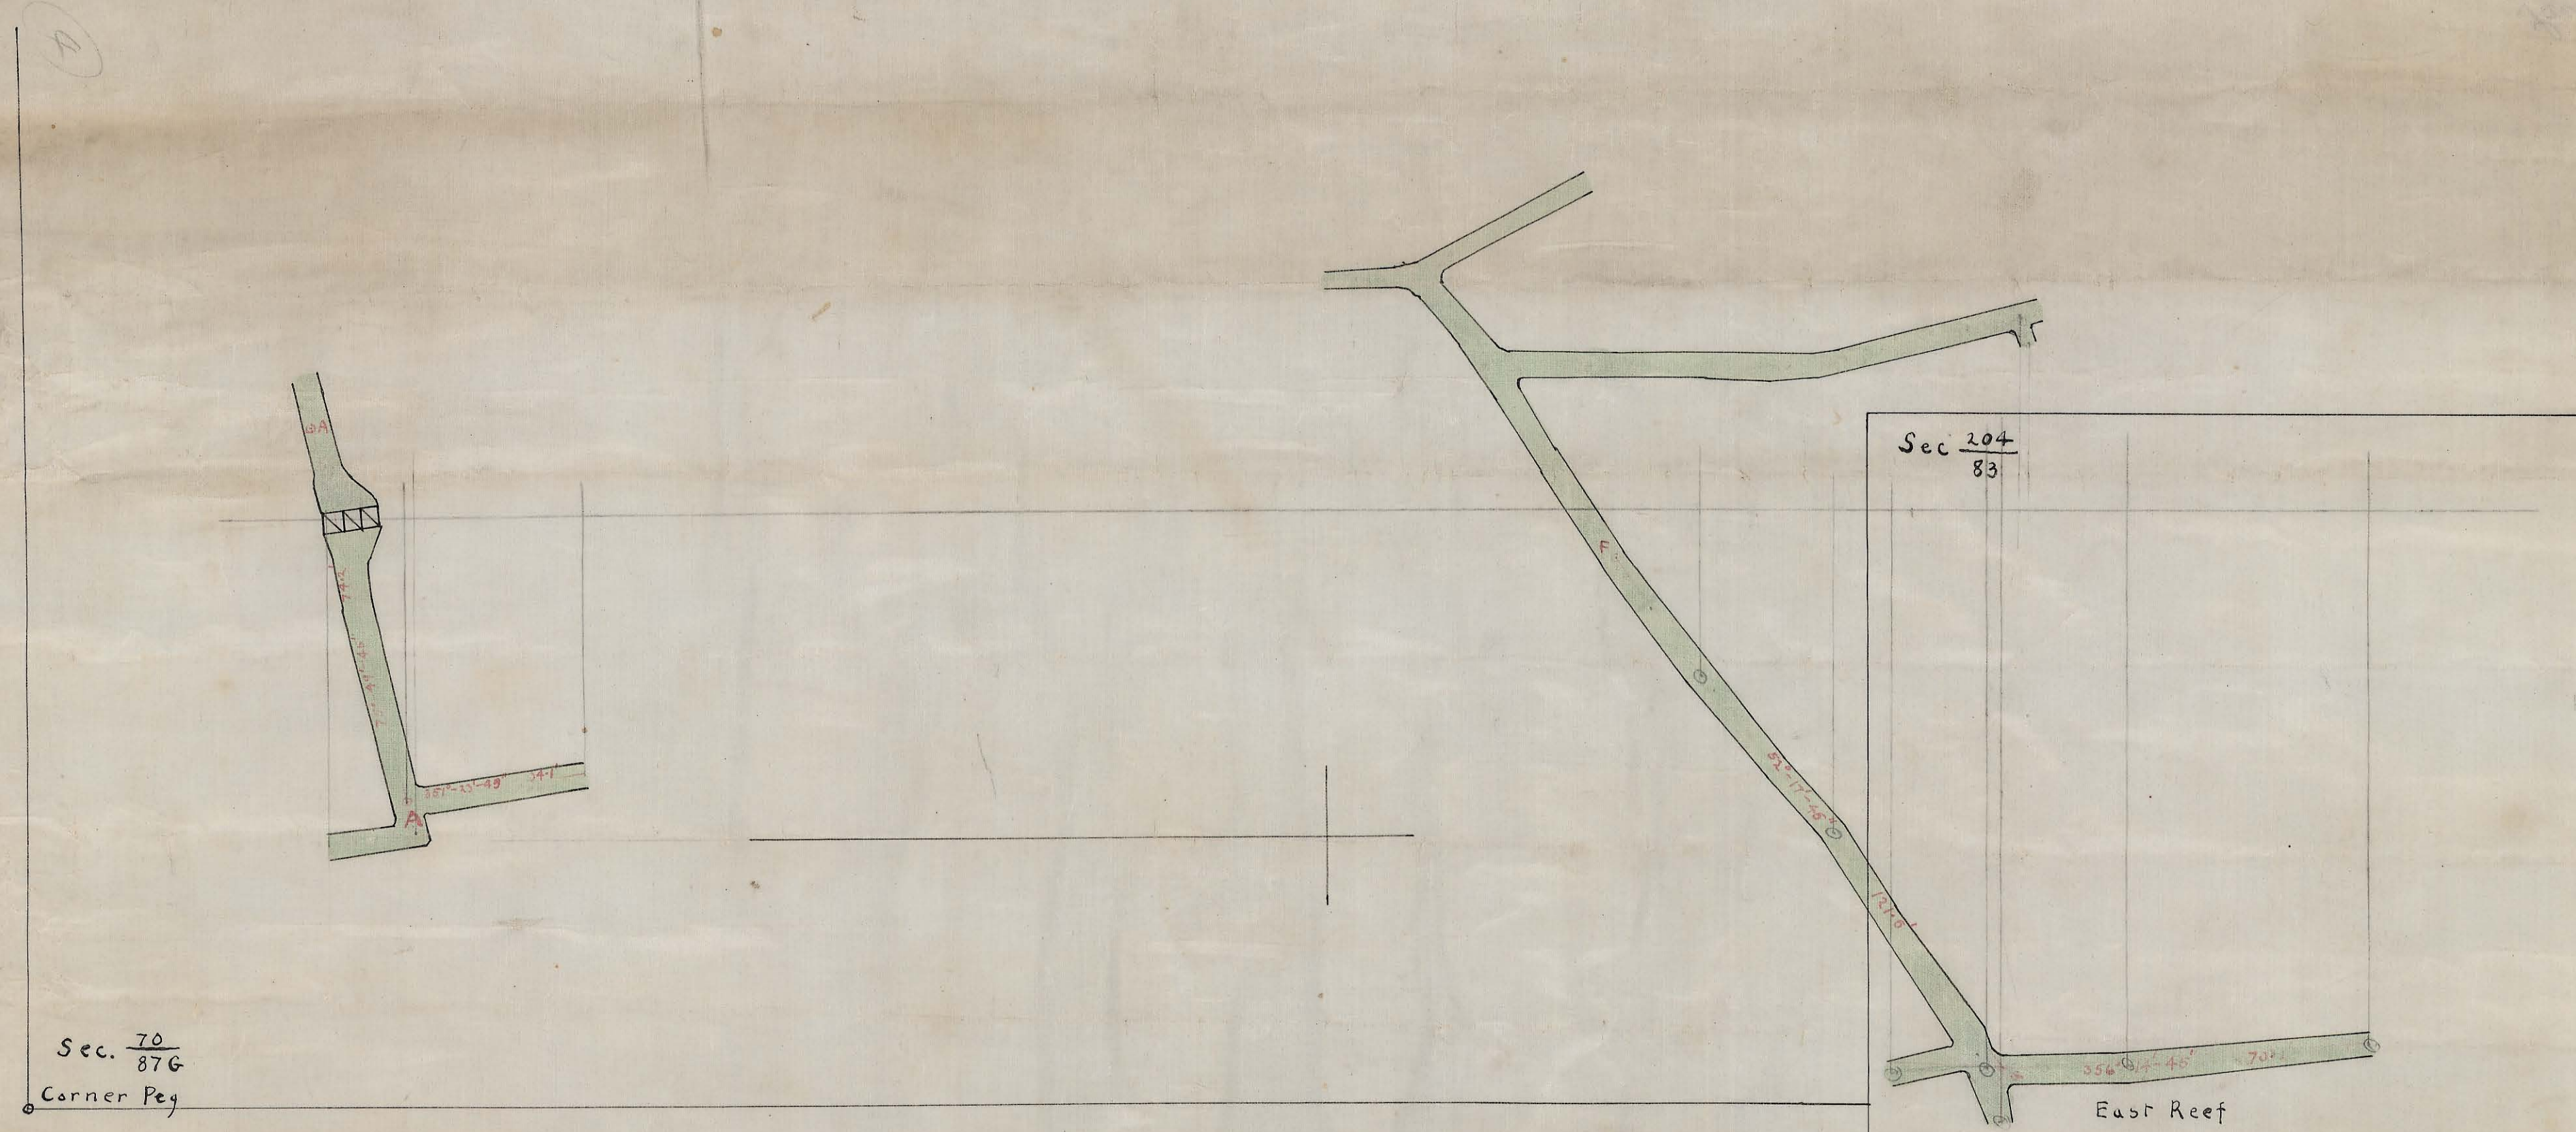


Sec. 70/876
Corner Peg

Sec. 204/83

East Reef

Tasmanian Consols Mine

Scale 25" = 1"

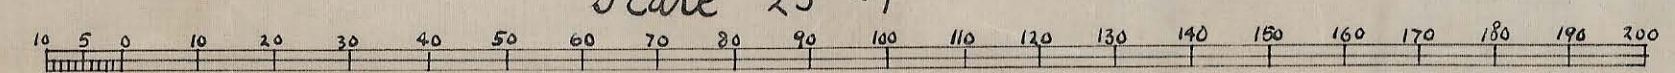

Plan shewing extension of 1200 ft Level to 31/12/06, corrected plotting of shaft, and Xcut East therefrom.

C. F. Fryer