



227-07

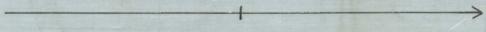

SCALE 25 FEET TO ONE INCH

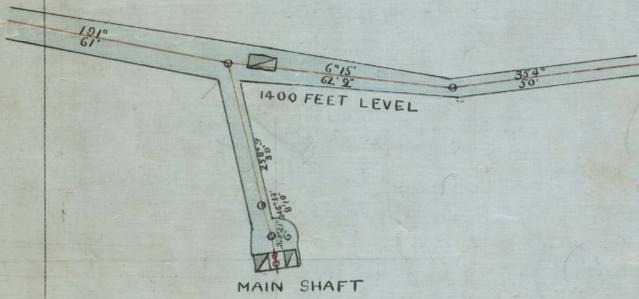

270°

SEC 70
87 G
10 AC.

360°

J. Andrew
Jan. 1906

PLAN

TASMANIAN

CONSOLS

MINE

