



TASMANIAN CONSOLS MINE

LONGITUDINAL SECTION LOOKING WEST

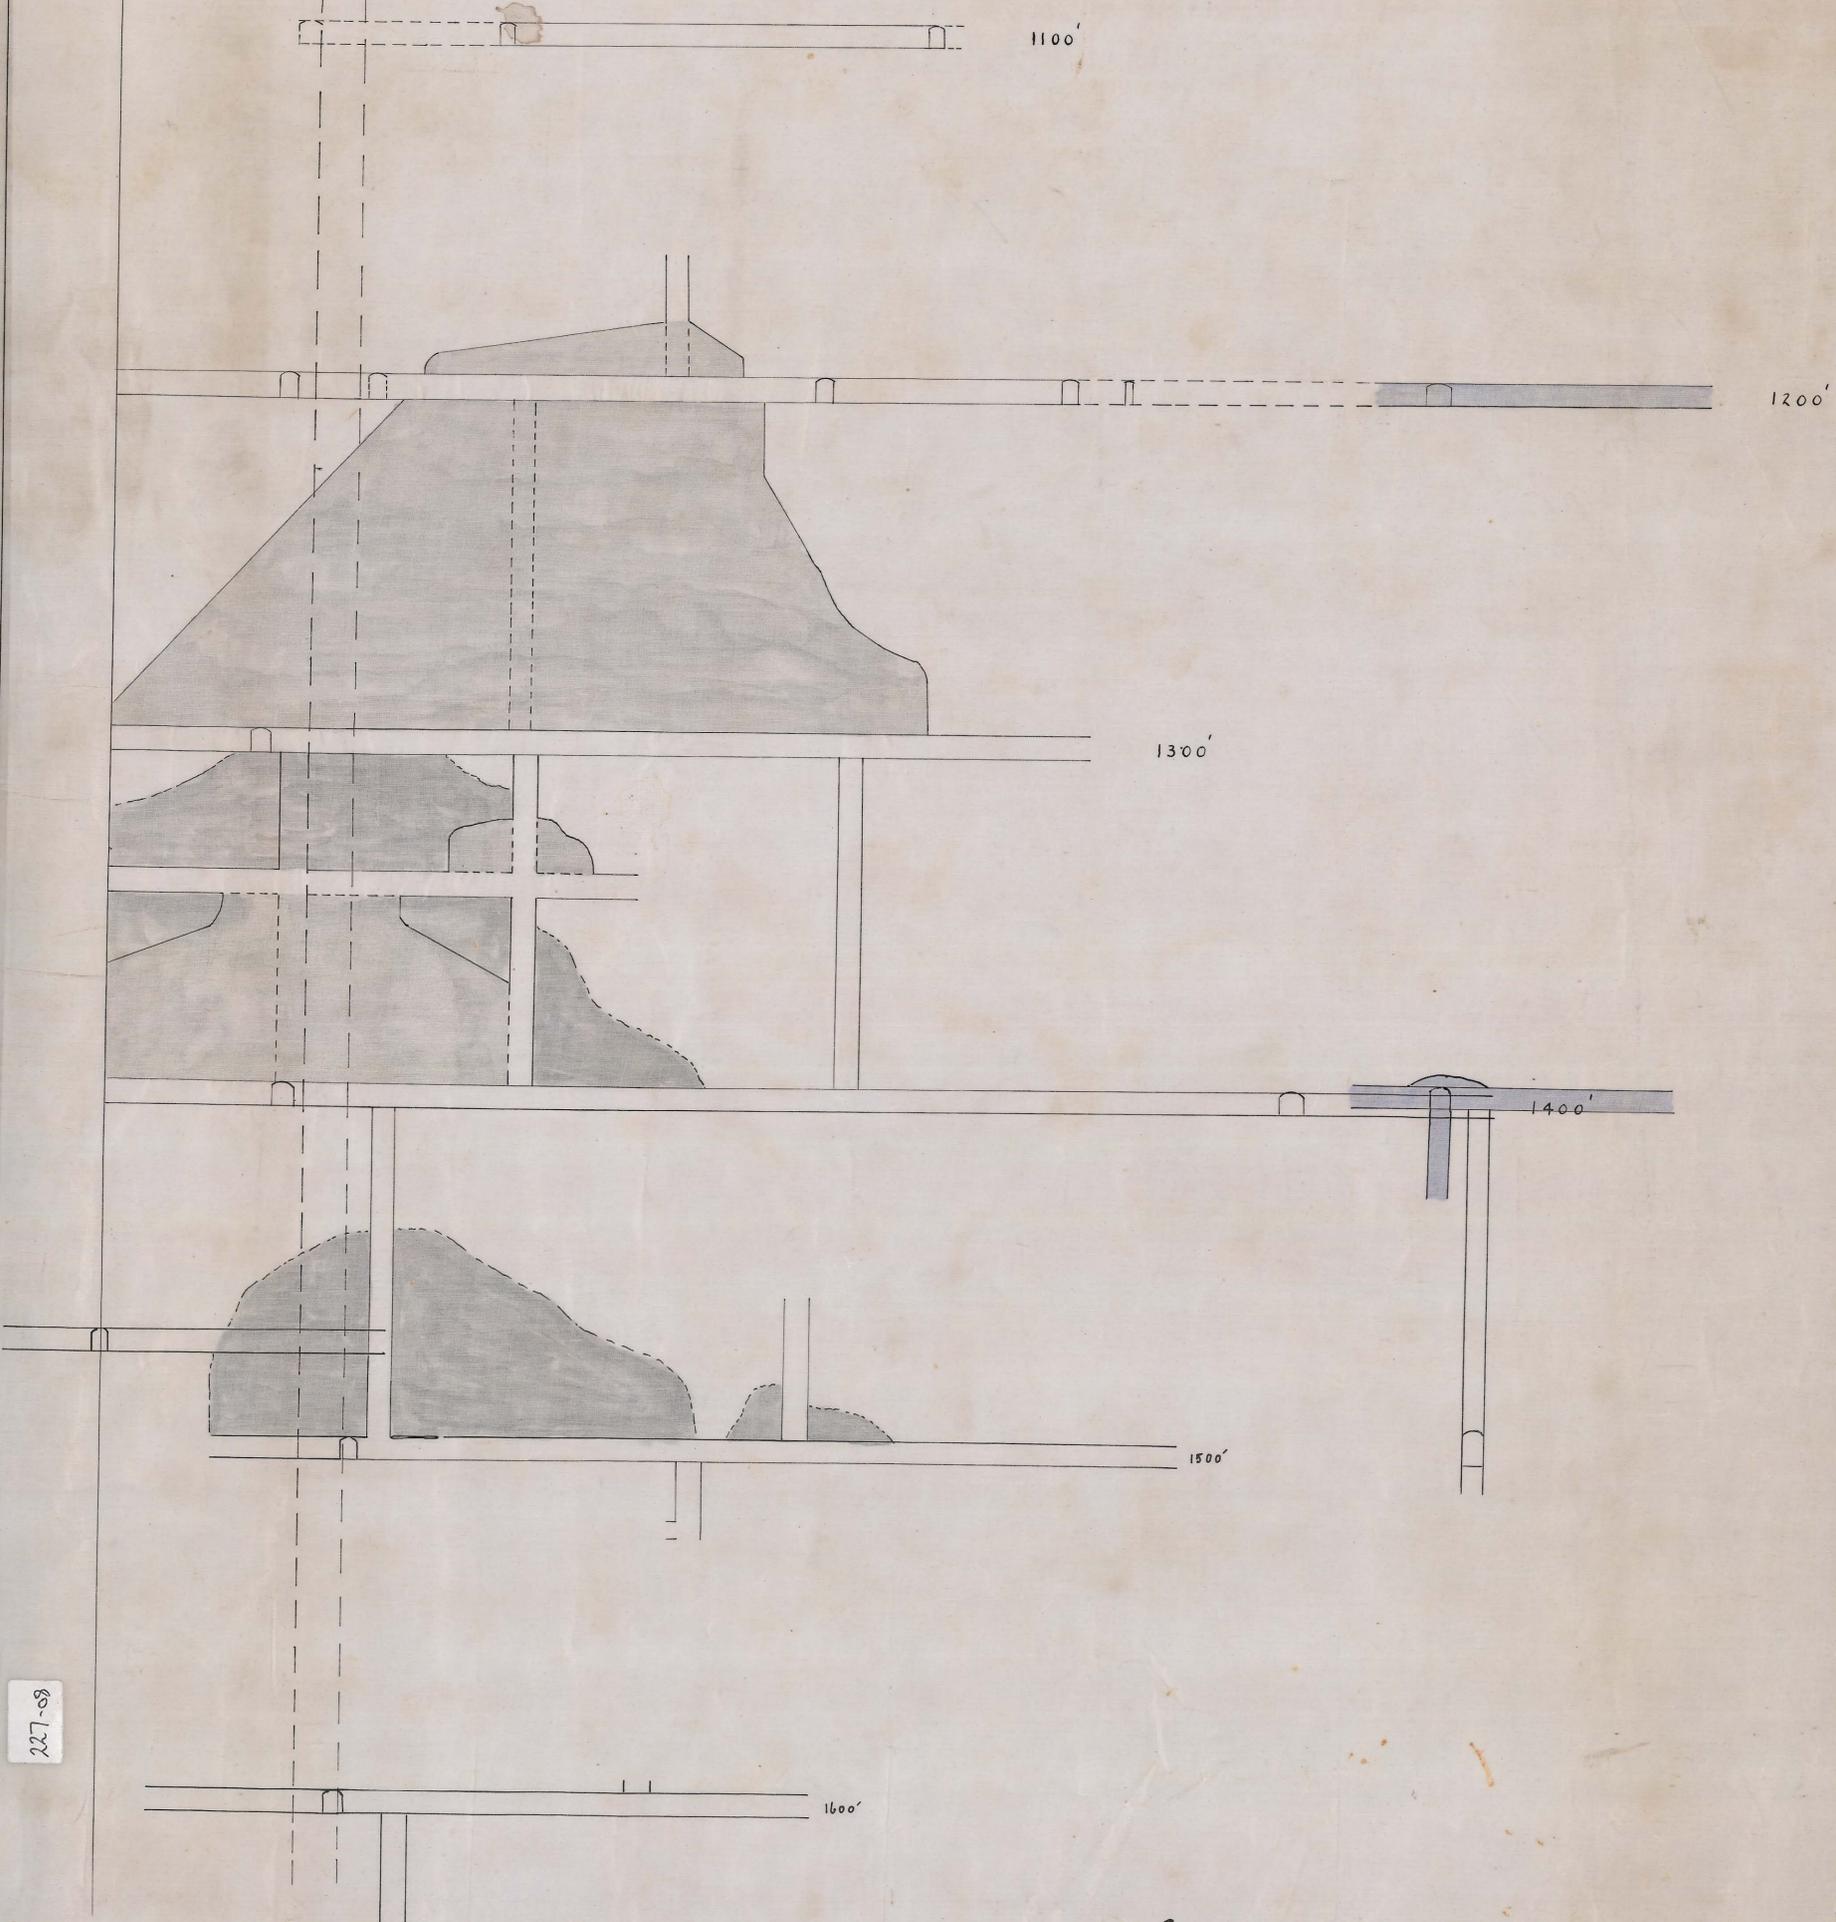

Scale 25 Feet = 1 Inch

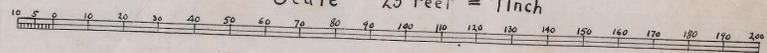

Stoped
Showing Work completed to 31/12/06
" " " 31/12/07.



C. F. Fryer
A. W. Heake.

25.000 hsh

Consols