


227-10

5 cm

227-10

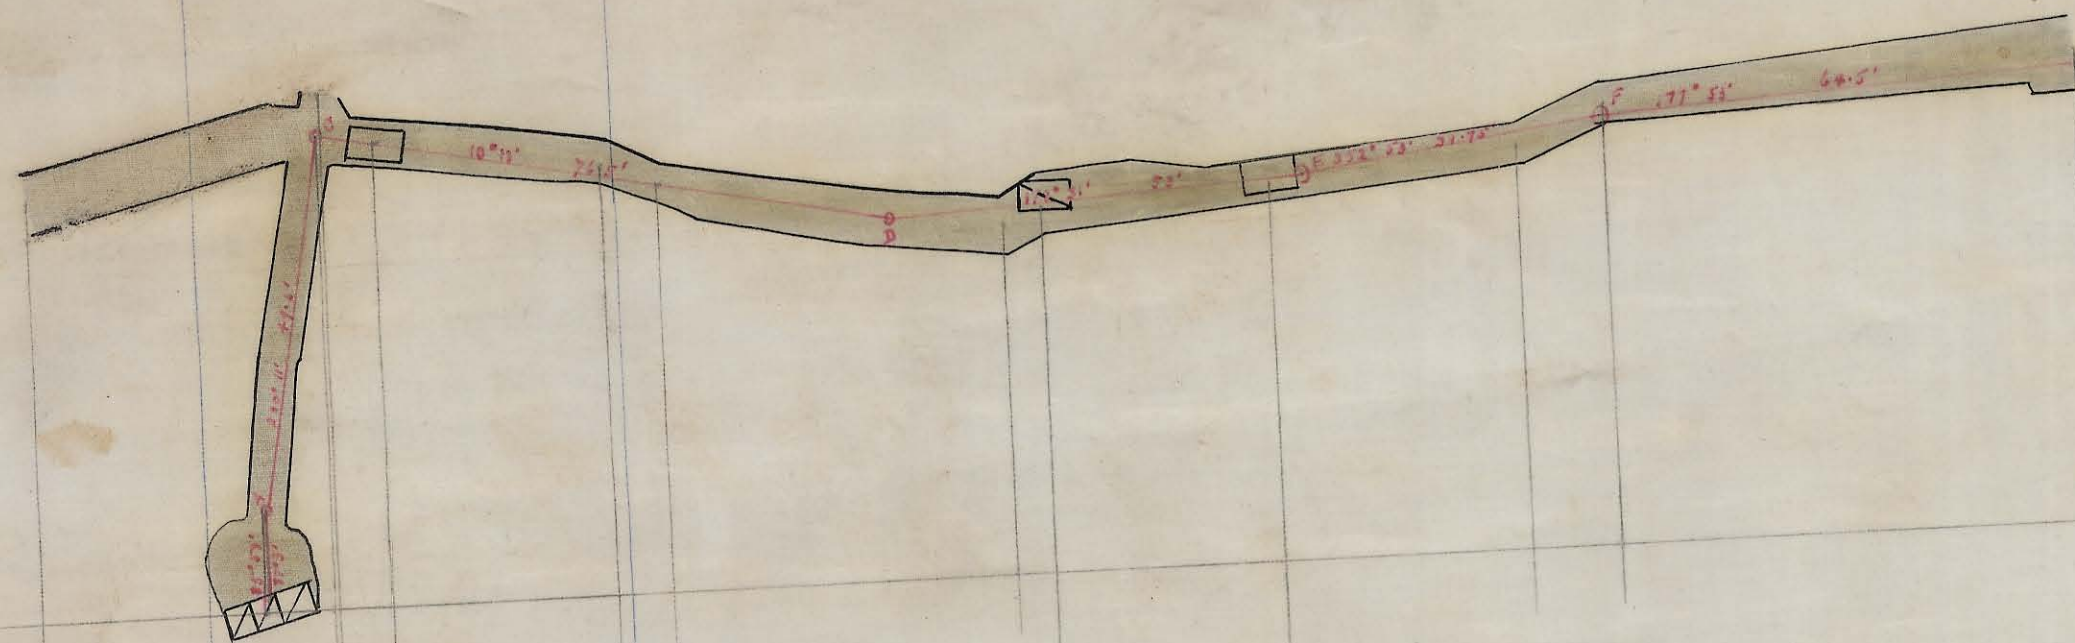

Sec. $\frac{204}{83}$

Sec. $\frac{70}{87A}$

corner Peg

TASMANIAN CONSOLS MINE

Scale 25 Feet = 1 Inch

NOTES

1500 Feet Level — 

GEOLOGICAL SURVEY
OF TASMANIA
25.8.08. *W.H.*

A.W. HOOKER