


227-12

5 cm

227-12

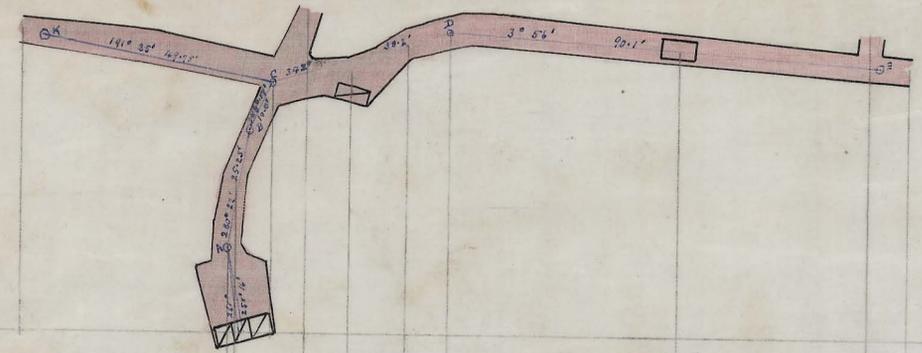


Sec.  $\frac{70}{874}$   
Corner Peg

Sec.  $\frac{204}{83}$

# TASMANIAN CONSOLS MINE

Scale 25 Feet = 1 Inch

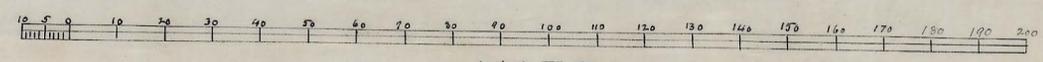

NOTES

1600 Feet Level

AW. HOOKE