

THE OONAH SILVER MINING COMPANY.

REC. NO LIA.

JUNCTION. S. M. C.
80 AC.




PLAN

Scale 2.5 feet to an inch

- | | | | | | | |
|-----------|----------|------------------|------------------|------------------|------------------|-----------|
| Old Shaft | Color do | W ^o 1 | W ^o 2 | W ^o 3 | W ^o 4 | Buildings |
|-----------|----------|------------------|------------------|------------------|------------------|-----------|

Revised by
Geological
Department
M.M.C.
Department
of the
Interior

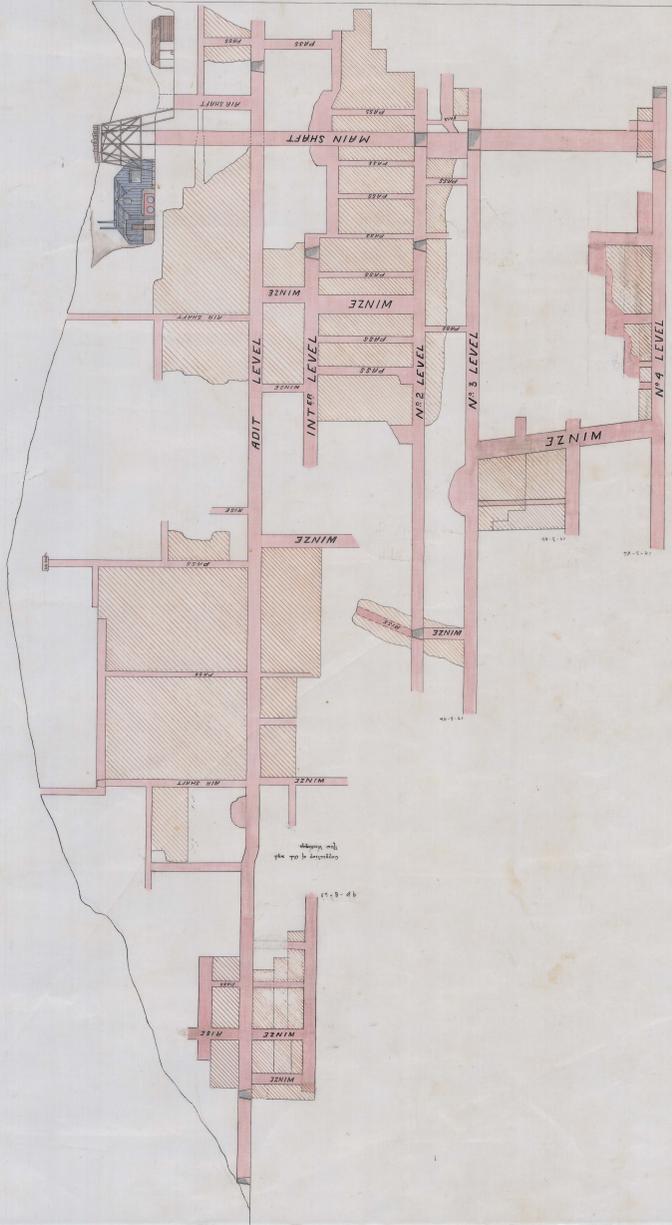

18 1/2 feet
19 1/2 feet