

23

5 cm

230-07

# THE OONAH S. M. CO.


## — SECTION ON COURSE OF "CROSS LODGE" —

230-07

Overl. 2.11.18  
1881

S

N

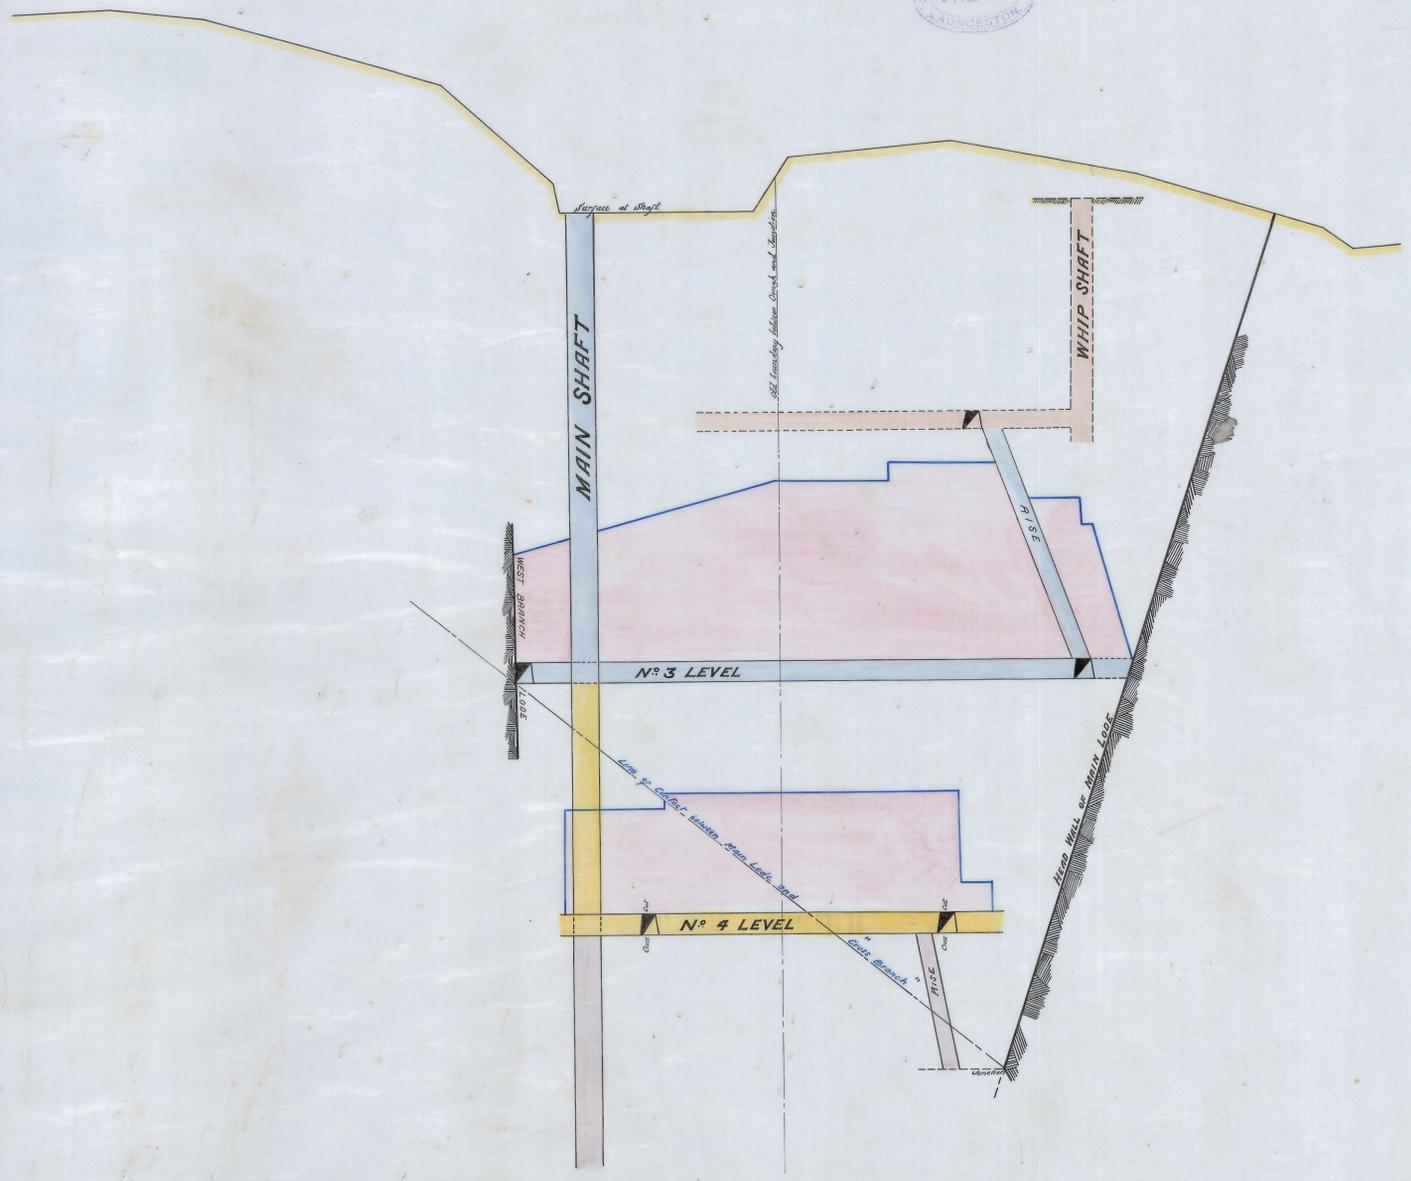

Signature

Slipping down during half year ending January 31<sup>st</sup> 1899

29