


1111 30 AC

1110 75 AC

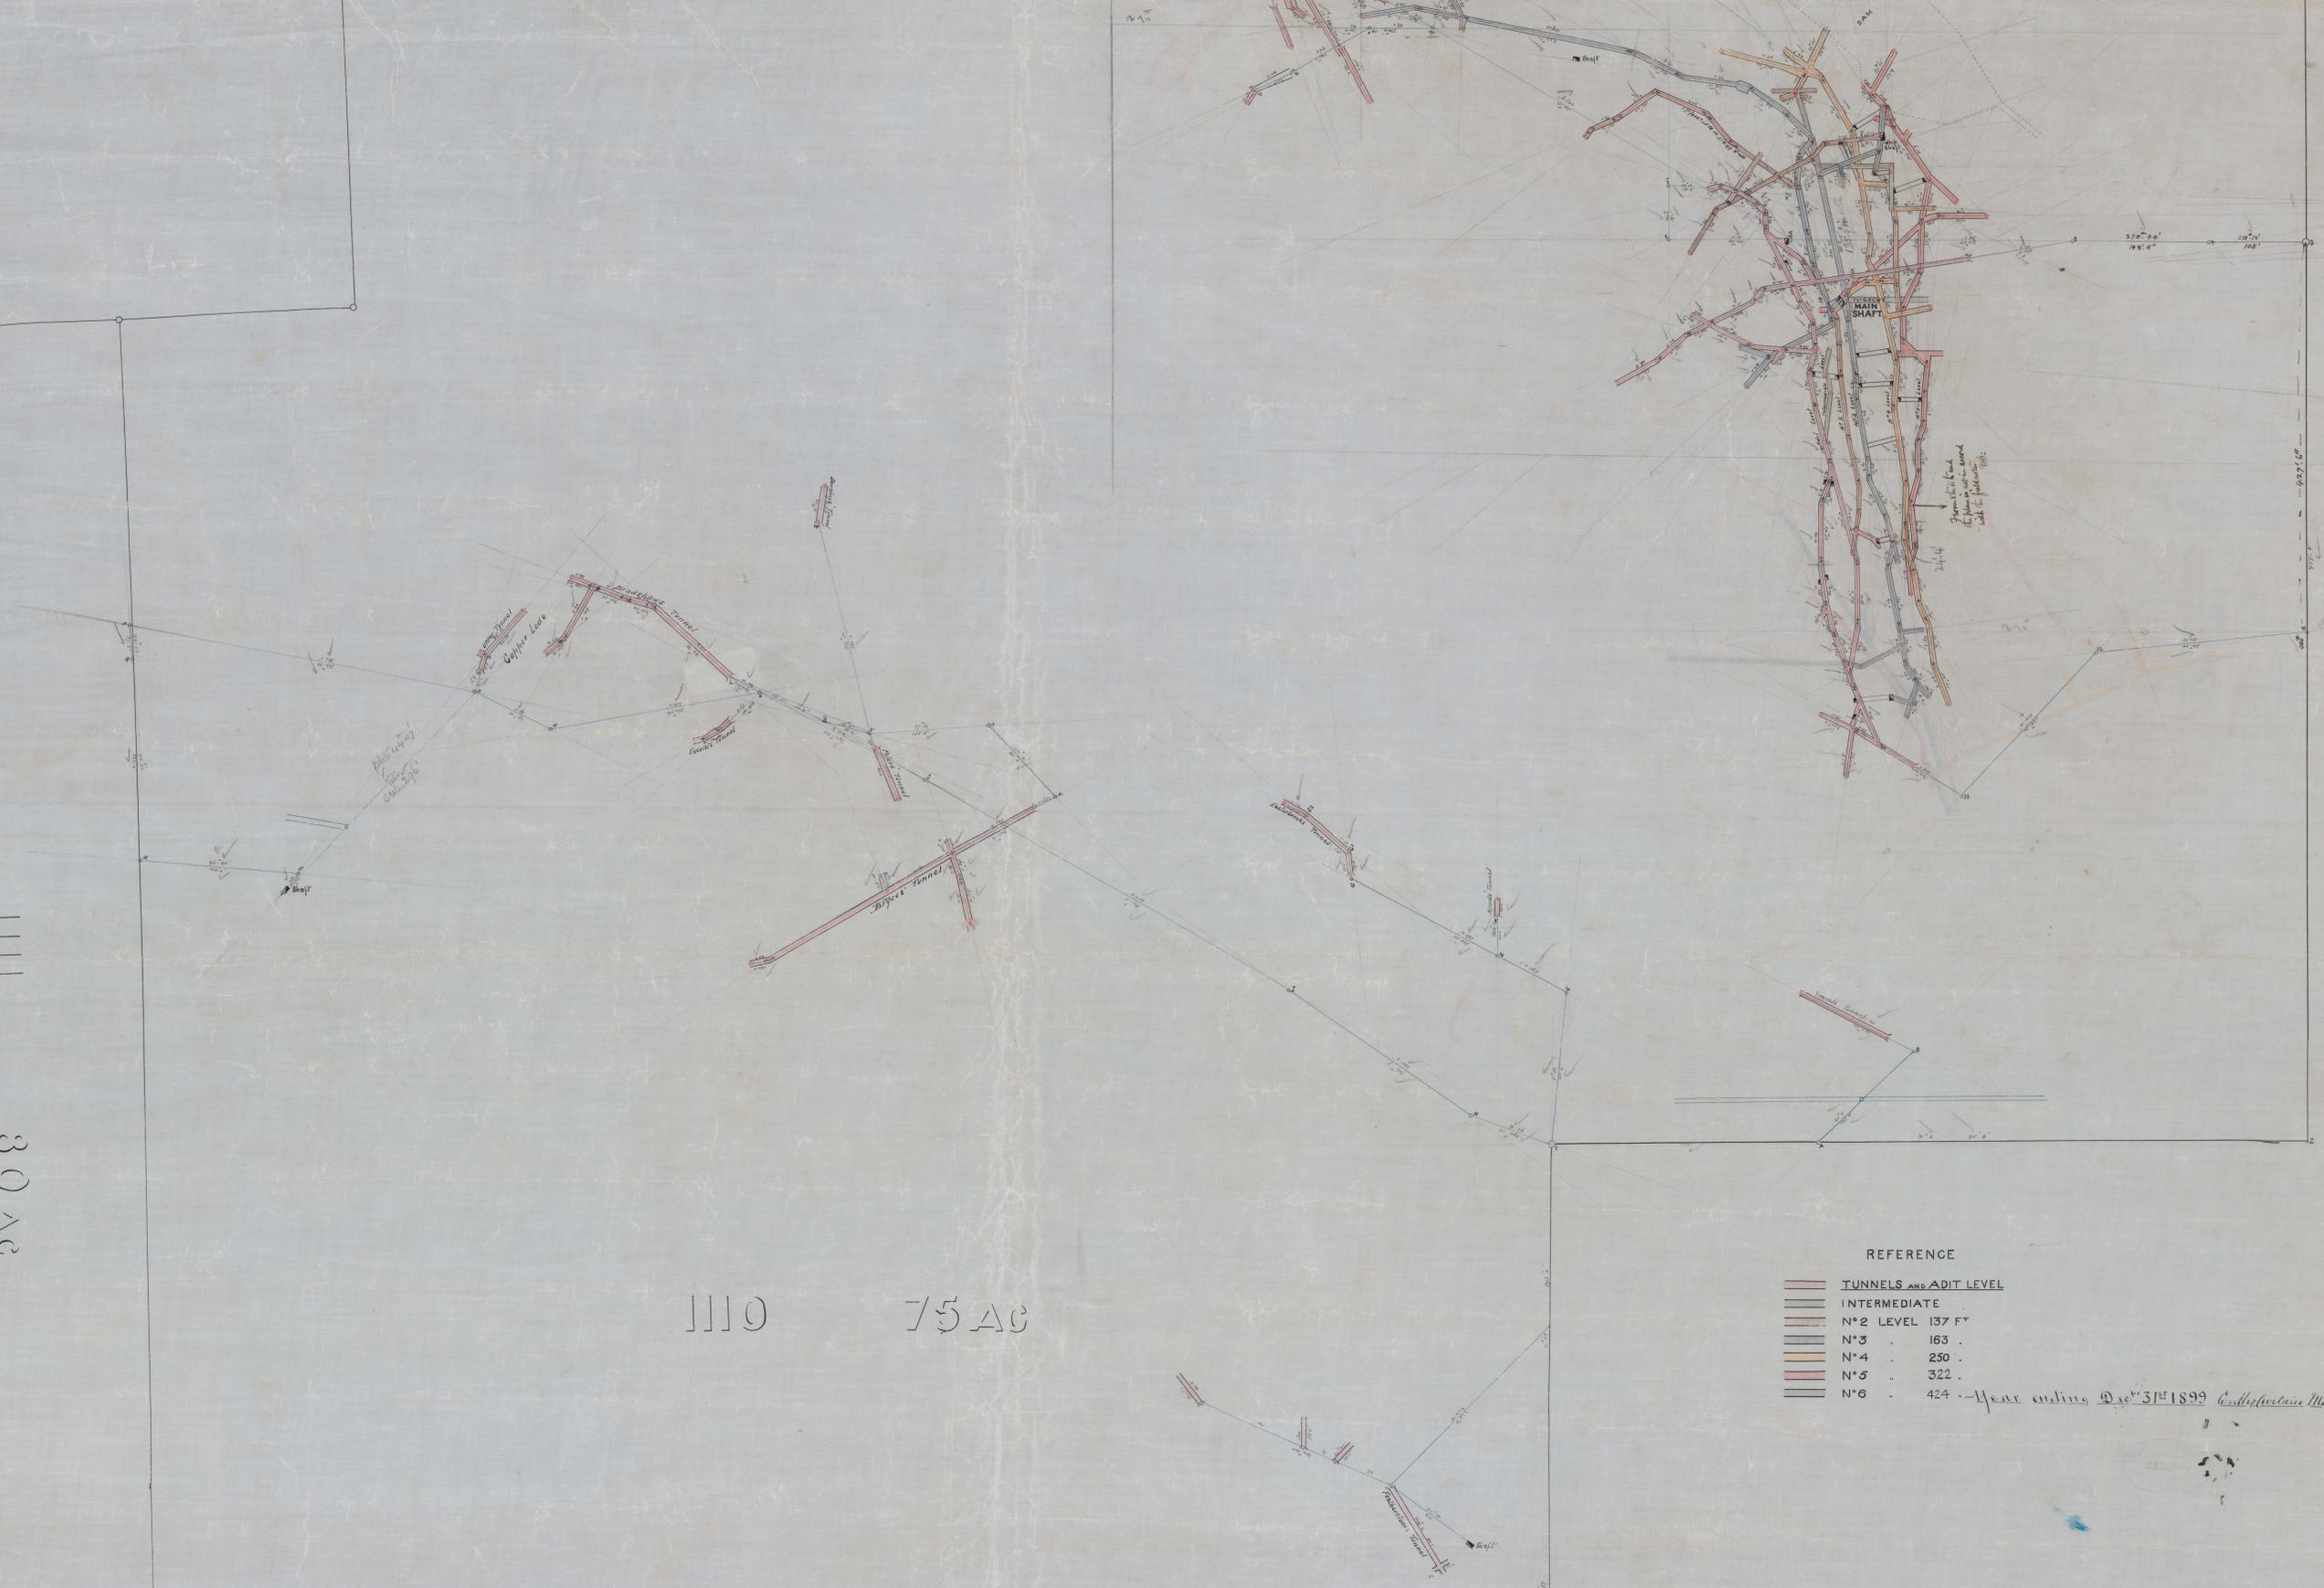

REFERENCE

|  |                        |
|--|------------------------|
|  | TUNNELS AND ADIT LEVEL |
|  | INTERMEDIATE           |
|  | N°2 LEVEL 137 FT       |
|  | N°3 . 163 .            |
|  | N°4 . 250 .            |
|  | N°5 . 322 .            |
|  | N°6 . 424 .            |

*Year ending Dec 31 1899* *Geological Survey*