


Couch L.M.

5 cm

230-17

*1116 1/2
1991 Jan 28*

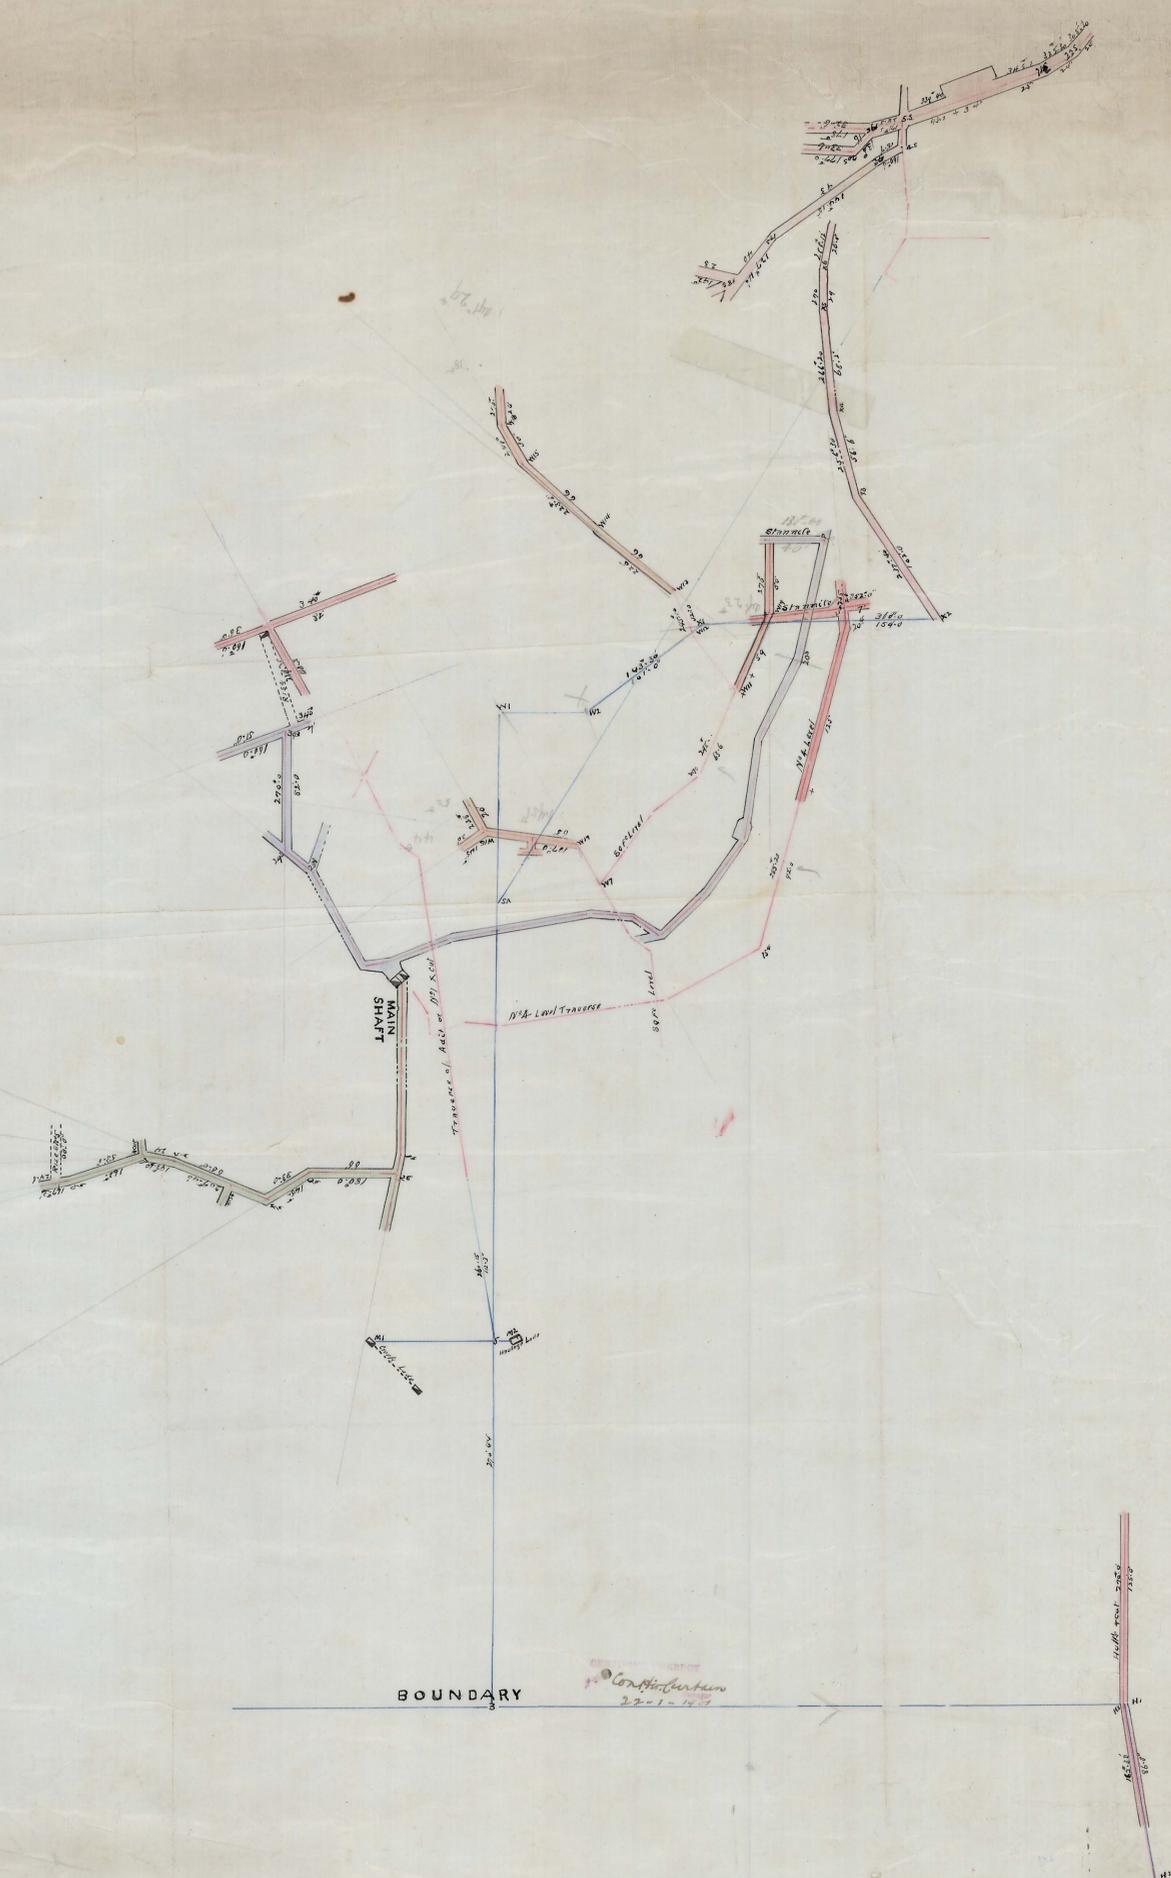

*Confidential
27-1-14*