



5 cm

230-19

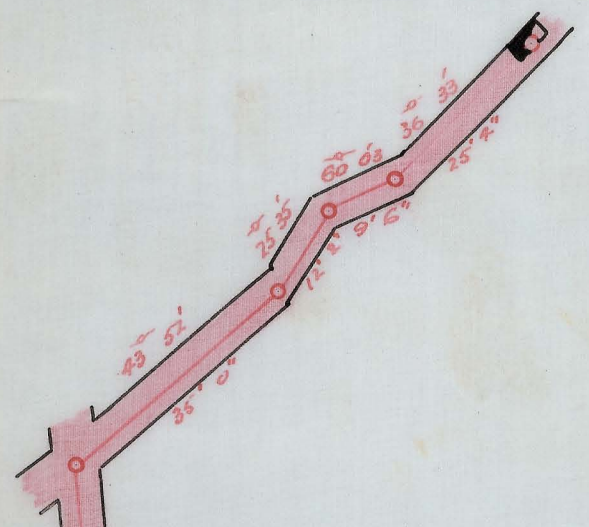

5.57 52
213° 5'

2.23 60
213° 5'

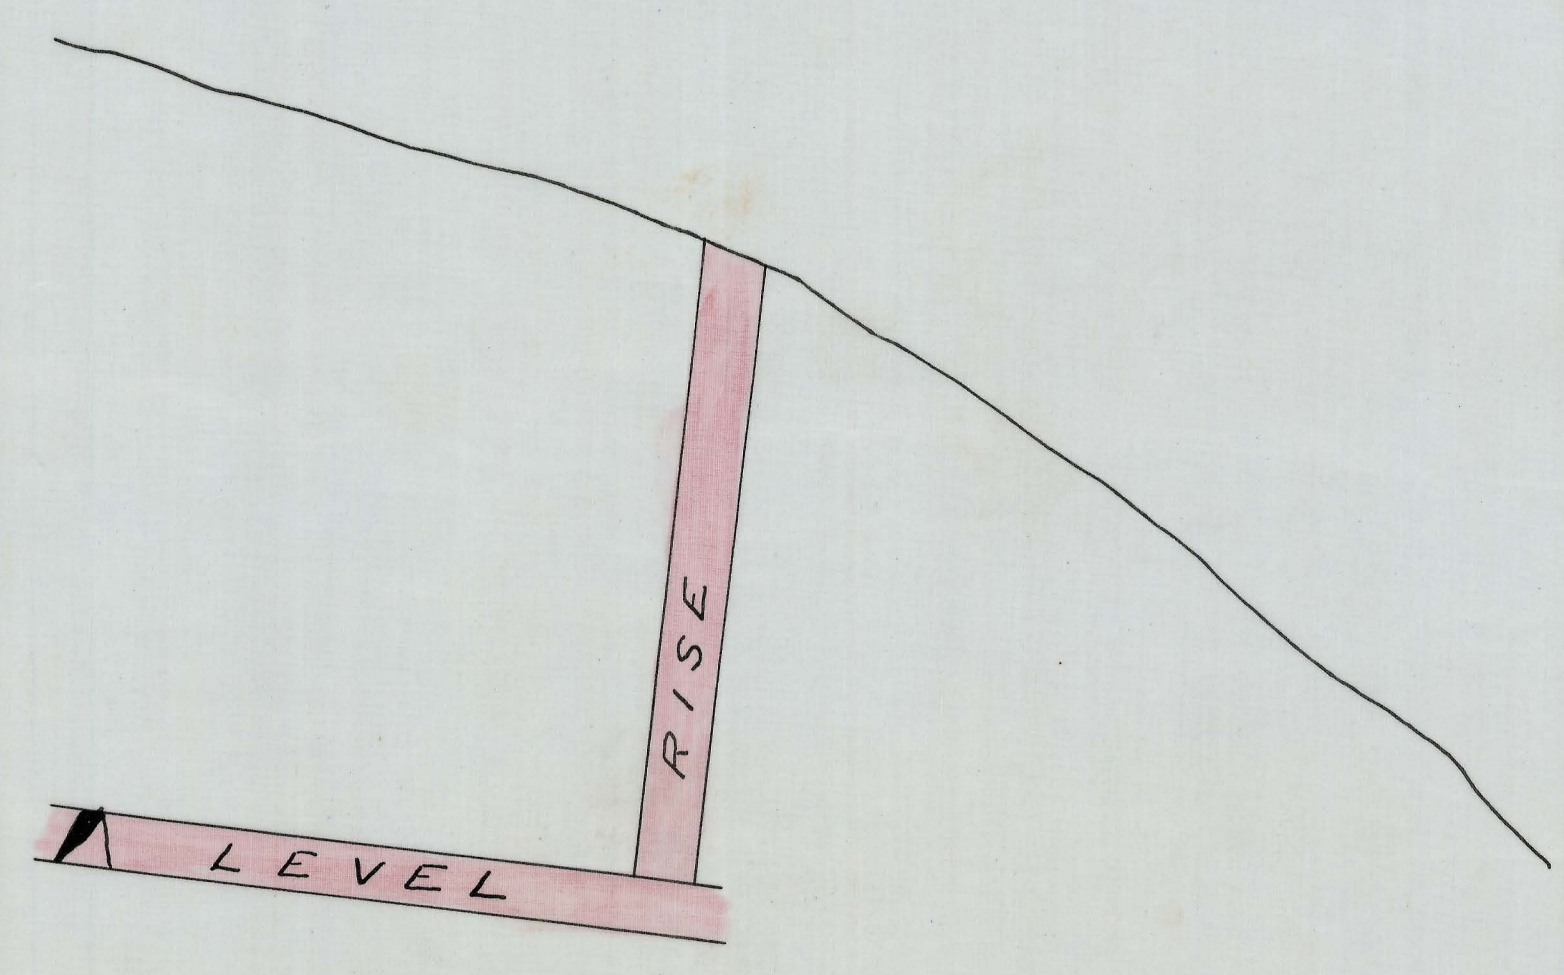

819 87M

00NAH S. M. C^o. N. L.
SCALE 25 Ft. TO 1 INCH
Instrument used 4" Theodolite

J. H. Leming
Genl. Mining Manager
30/10/4



S.E. Corner

Magnetic North

M. S. Ward
40-1-12