
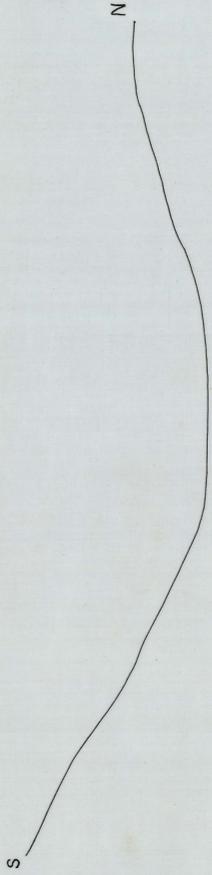


280-20

280-20

5 cm

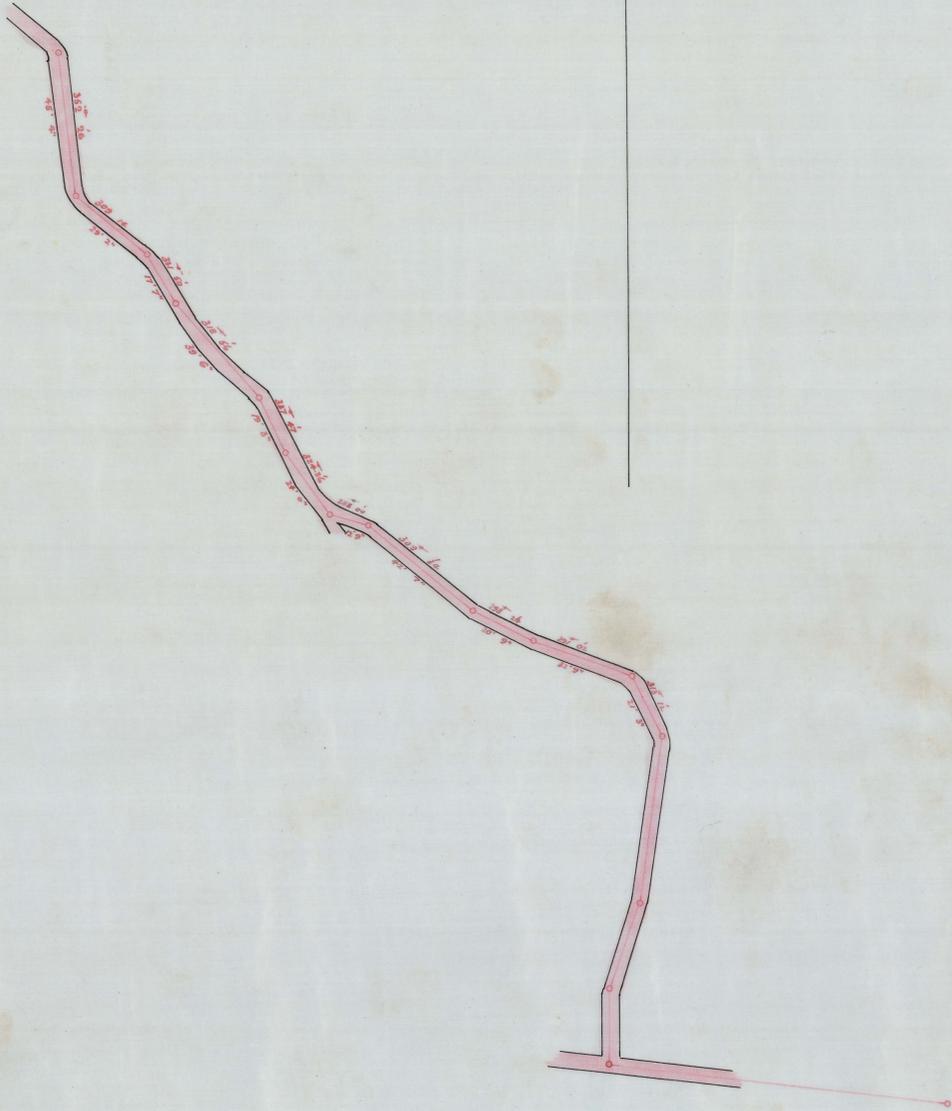

LOWER ADIT LEVEL SECTION

**COONAH S.M. CO. N.L.**  
**SCALE 25 FT. TO 1 INCH**  
**189 87 M.**

Instrument used 46" Theodolite

*J. H. Levinge*  
*Chief Mining Manager*  
*30/1/04*

200 Ft. from S.E. Corner

