


150
2001 Mr. A. J. ...

— THE — OONAH — S — M — COY. —

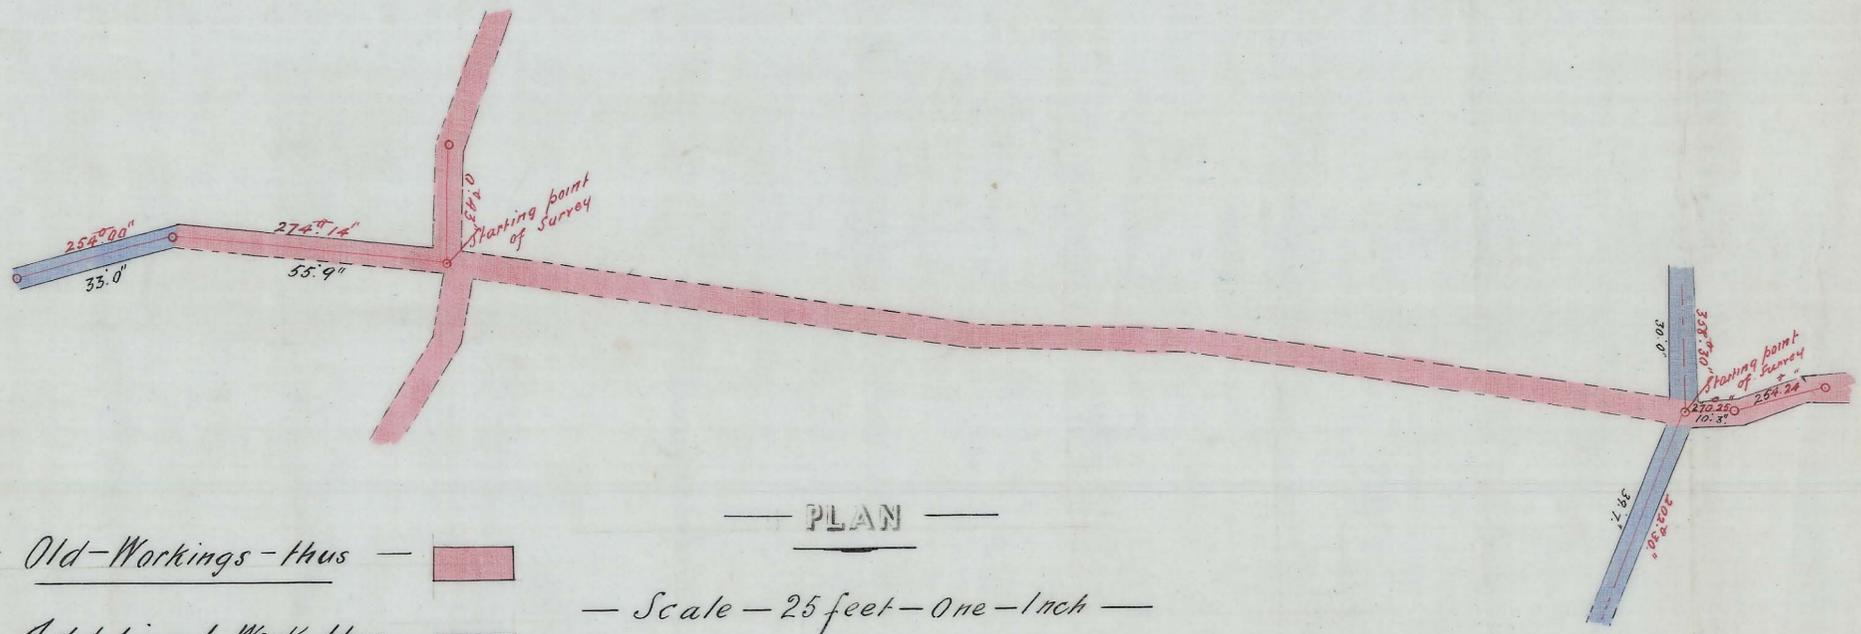



— PLAN —

— Old-Workings — thus —

— Additional-Work — thus —

— Scale — 25 feet — One — Inch —

— F. Climie —
— March 8th 1906 —

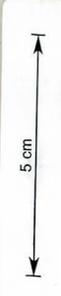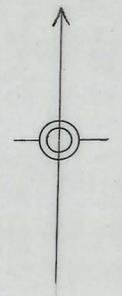

230-23

230-23

150