


5 cm

230-25

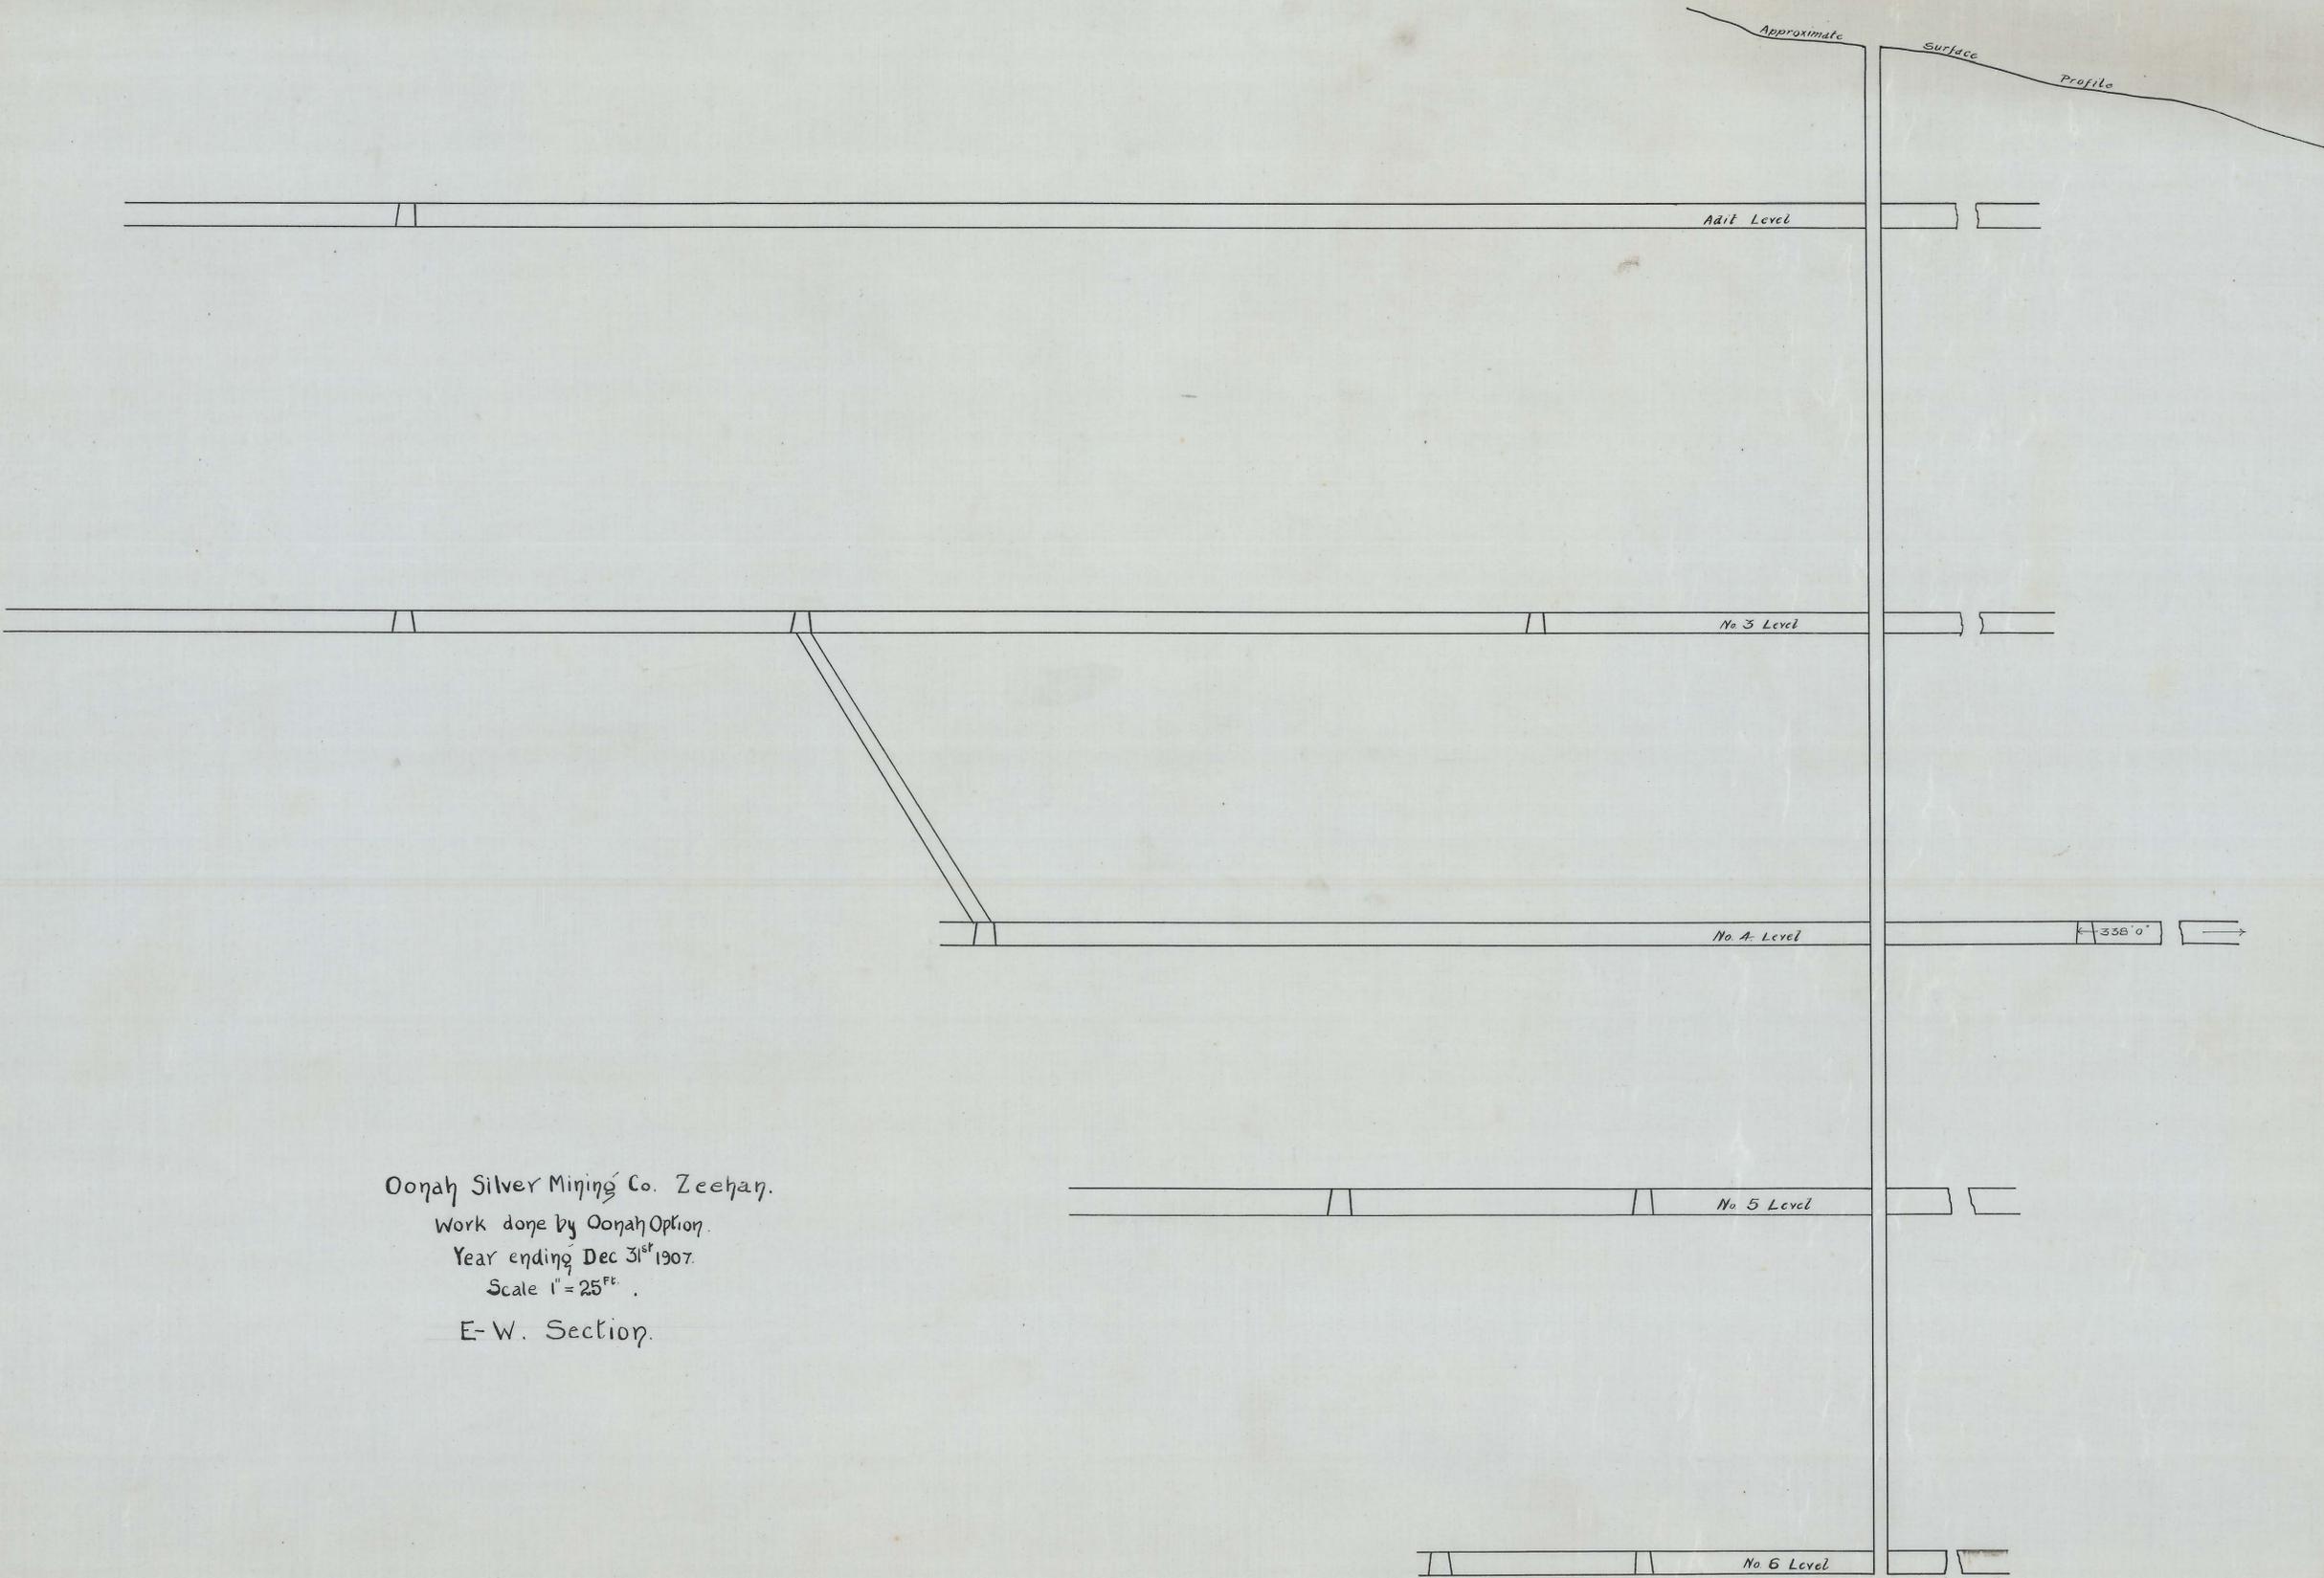

Oonah Silver Mining Co. Zeehan.
 Work done by Oonah Option.
 Year ending Dec 31st 1907.
 Scale 1" = 25^{ft}.
 E-W. Section.

Handwritten signature
 April 1908.