


230-26

230-26

5 cm

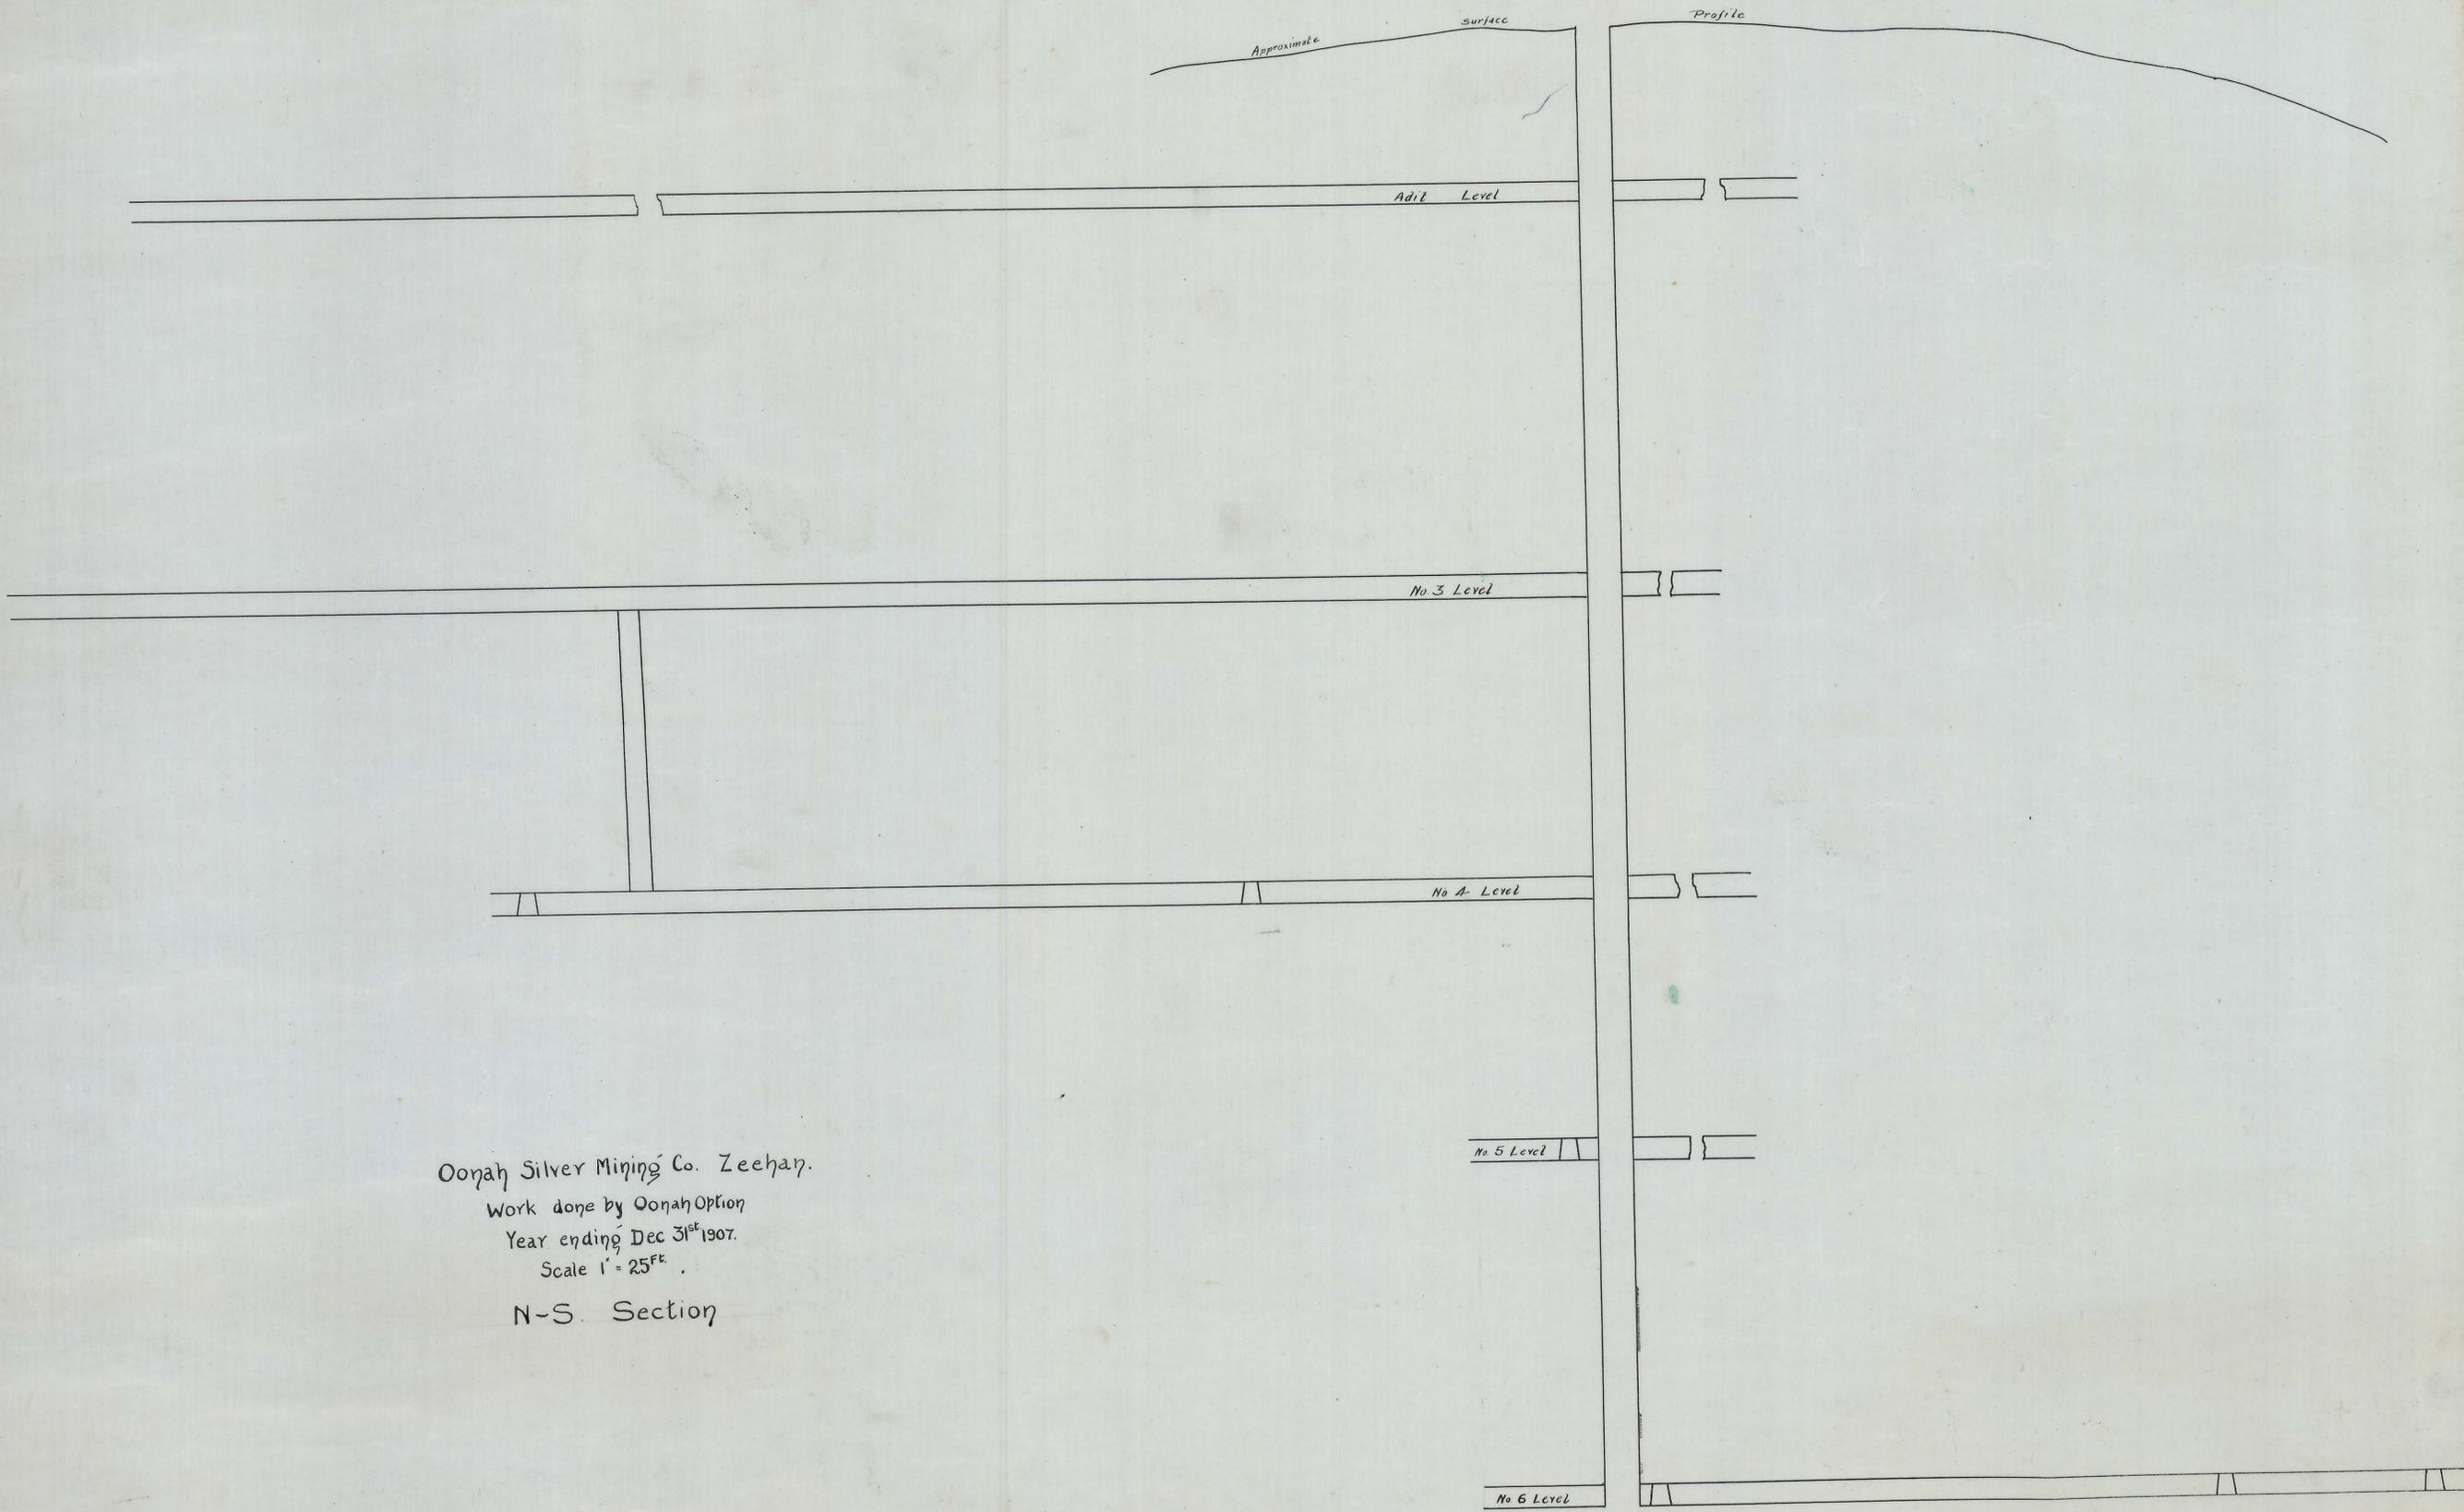

Oonah Silver Mining Co. Zeehan.
 Work done by Oonah Option
 Year ending Dec 31st 1907.
 Scale 1" = 25^{ft}.
 N-S. Section

Arthur Gordon
 April 1908