


THE OONAH MINE

PYRITES WORKINGS

Scale 40 Ft. to 1 Inch


*Rev. W. L. Reid
May 1912*

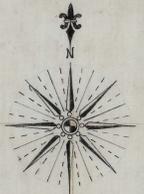

— PLAN —

— LONGITUDINAL SECTION —

— Projection on AB —

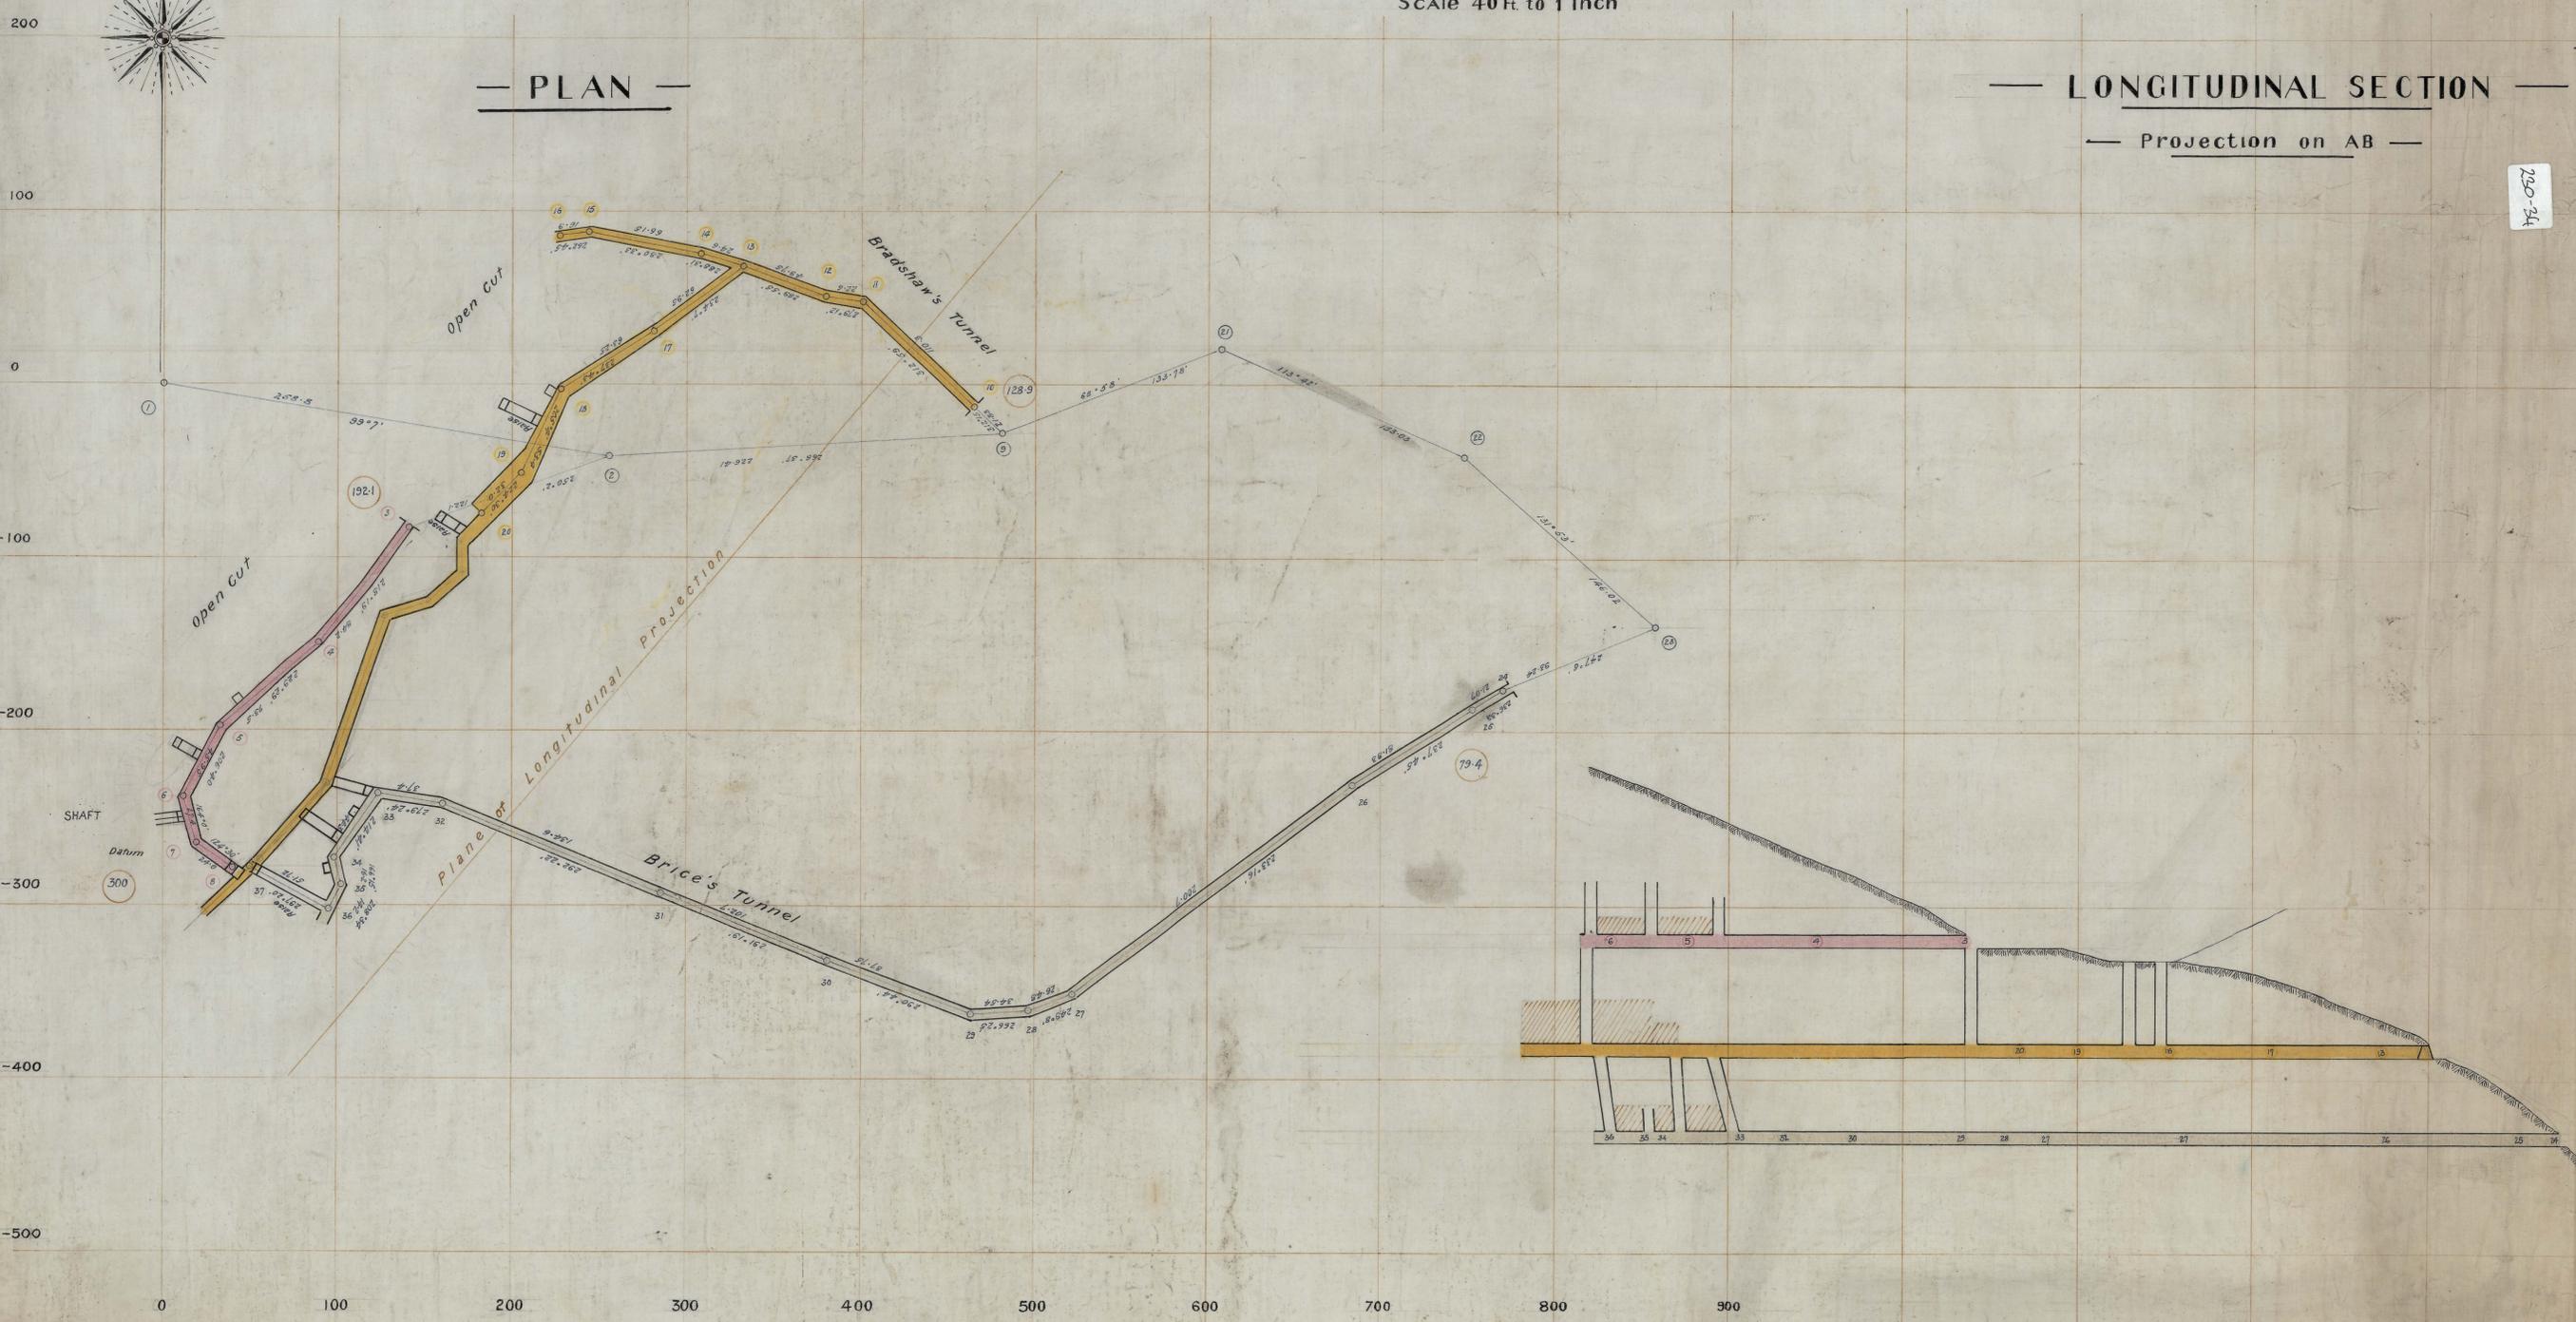

230-24

230-24

150