

X


5 cm
0230-039

LONGITUDINAL SECTION

MAIN LODE

Scale 100ft to an Inch

ZEEHAN WESTERN

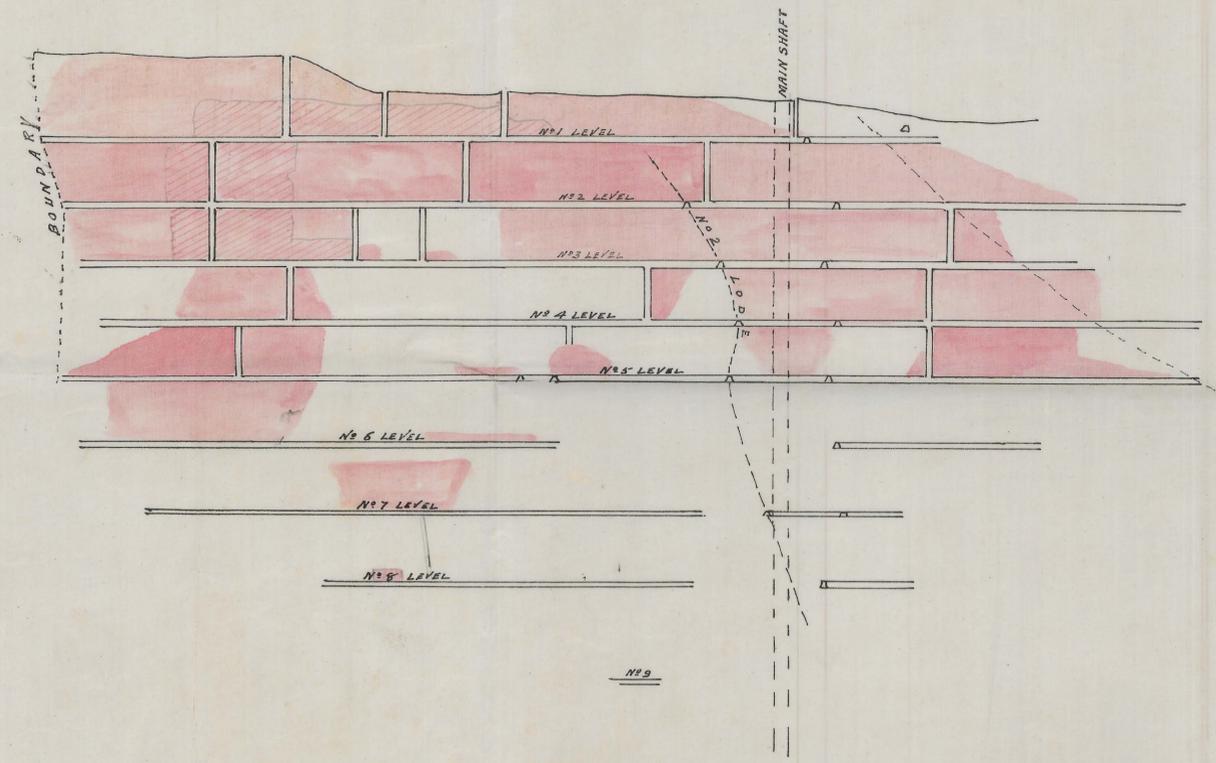

Zeehan Field
March 1908
Sand

755 LONGITUDINAL SECTION
87 M NO. 2 LODE

892
87 M

Scale 100 feet to an Inch

