


0230-041

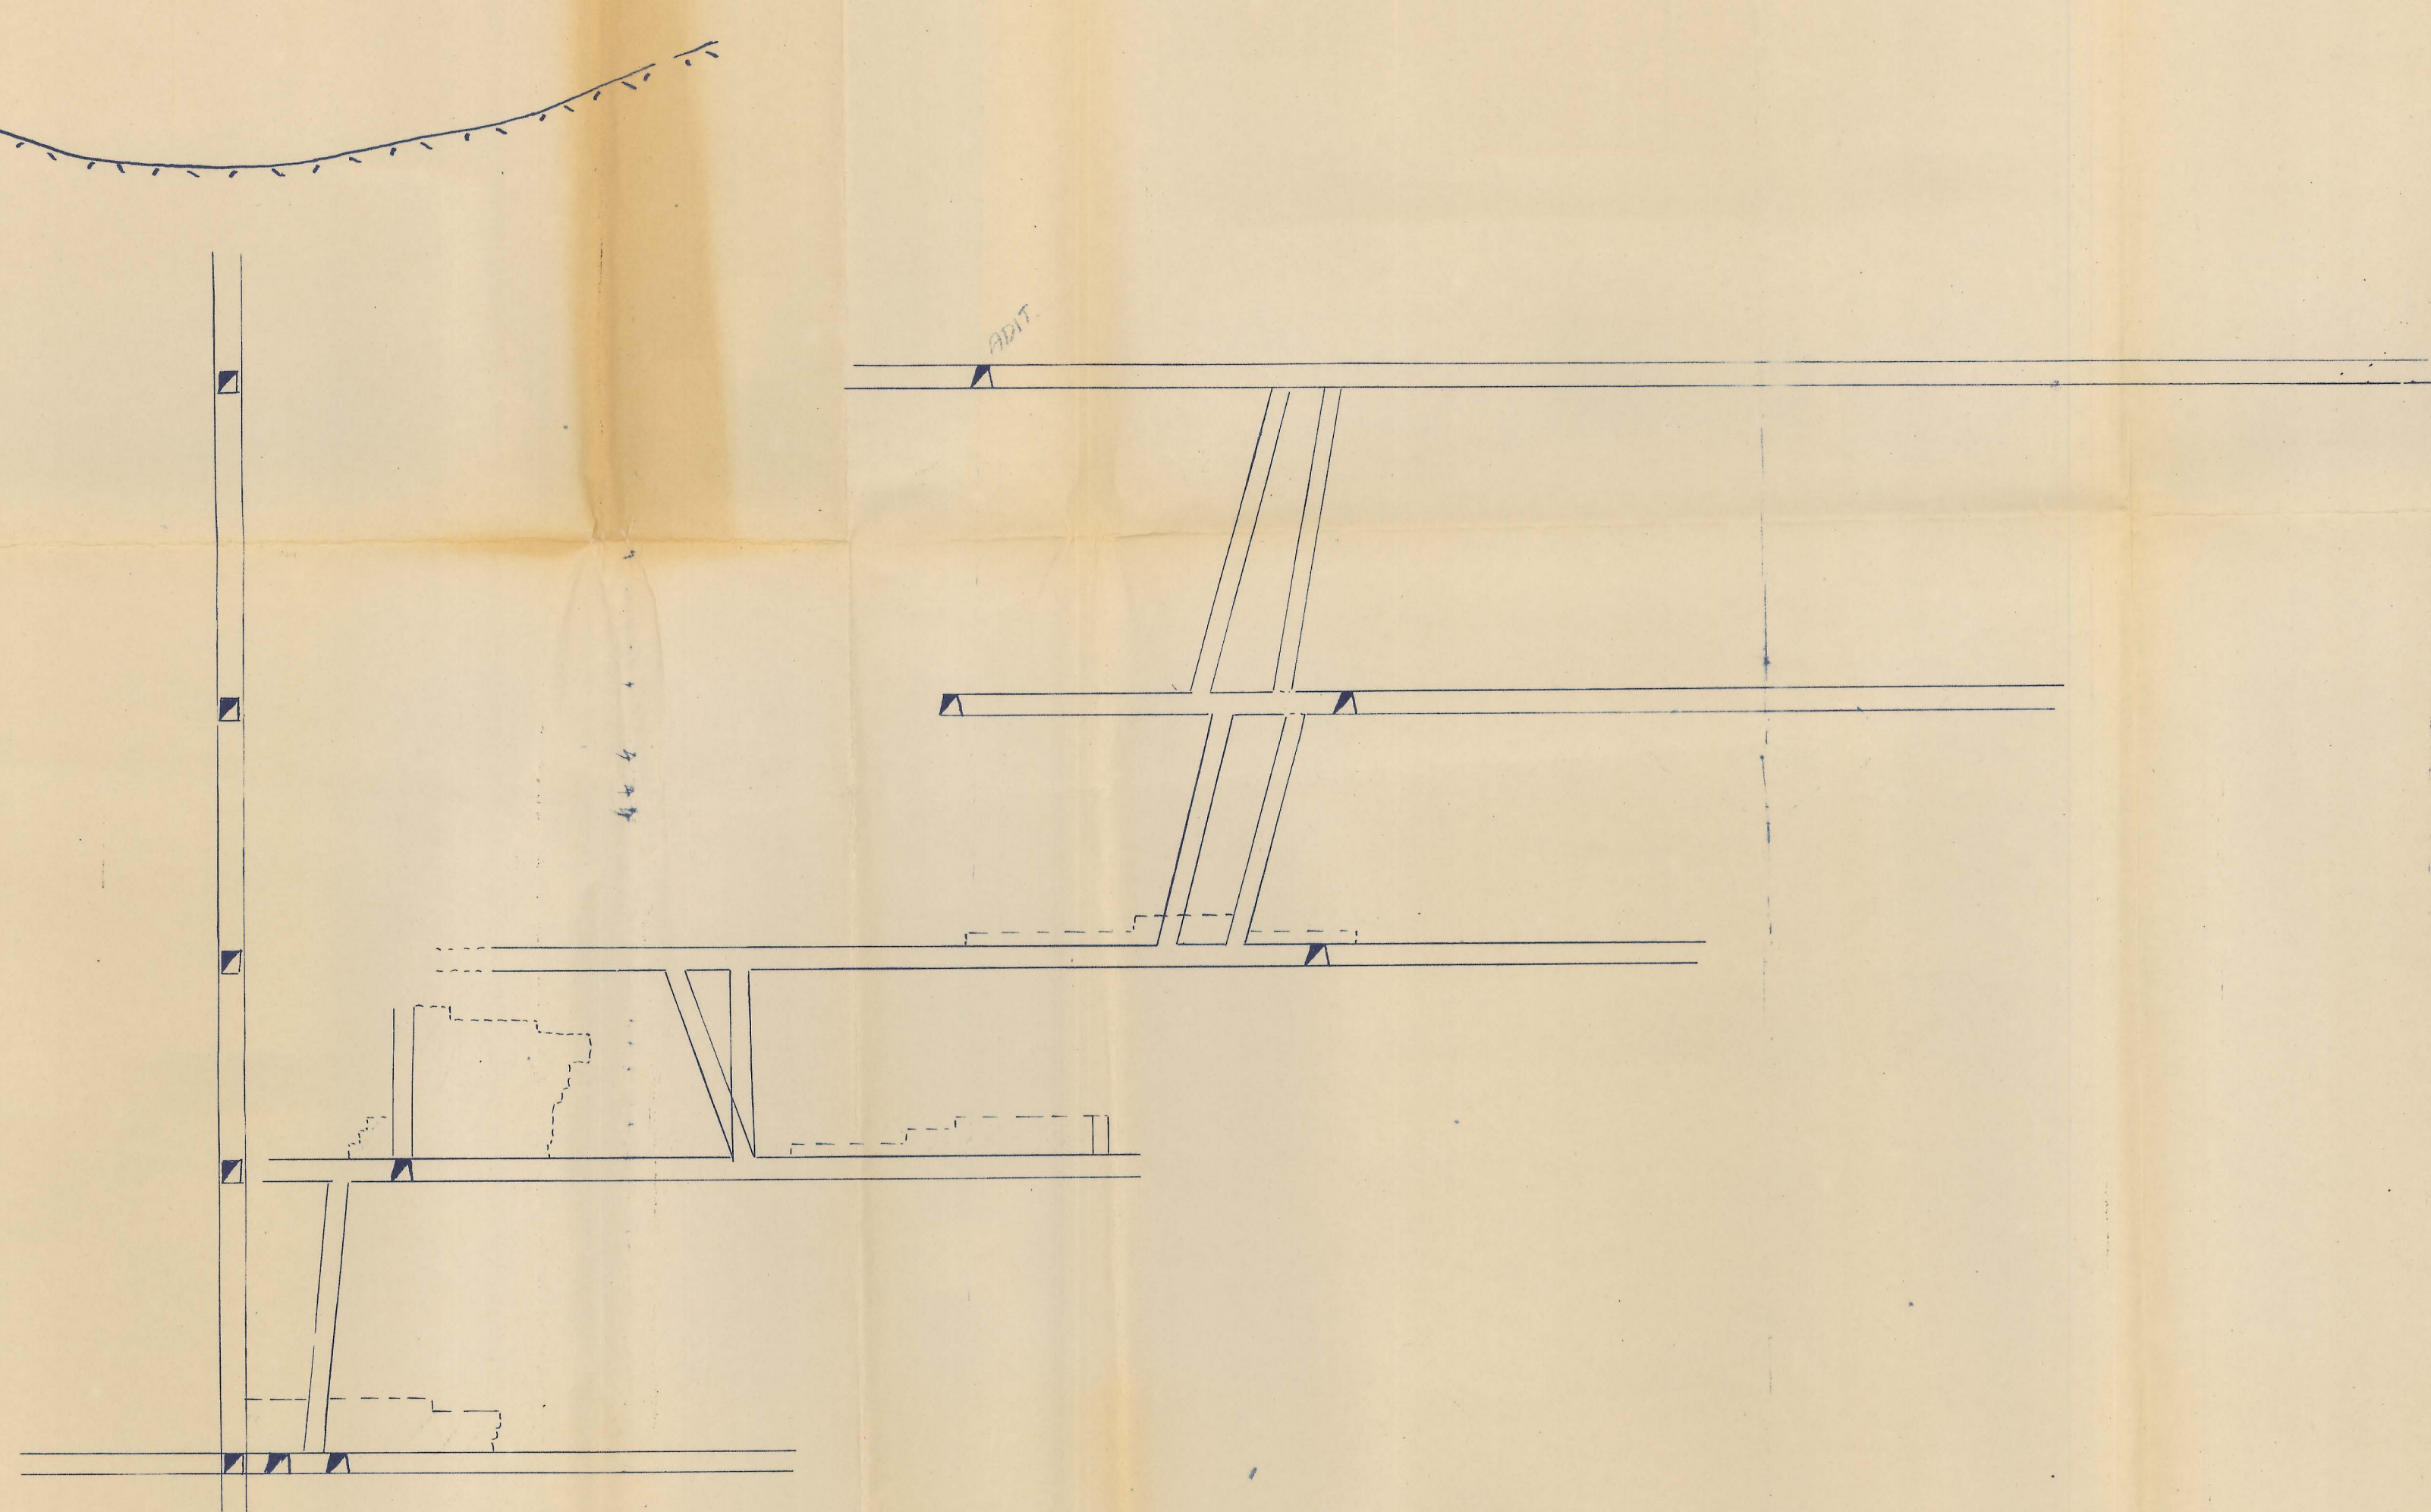

This was on back of sheet
"ON LINE AB
STANNITE LODE"
Traced G.F.W. 7-5-47

5 cm

0230-041