


0230 - 048

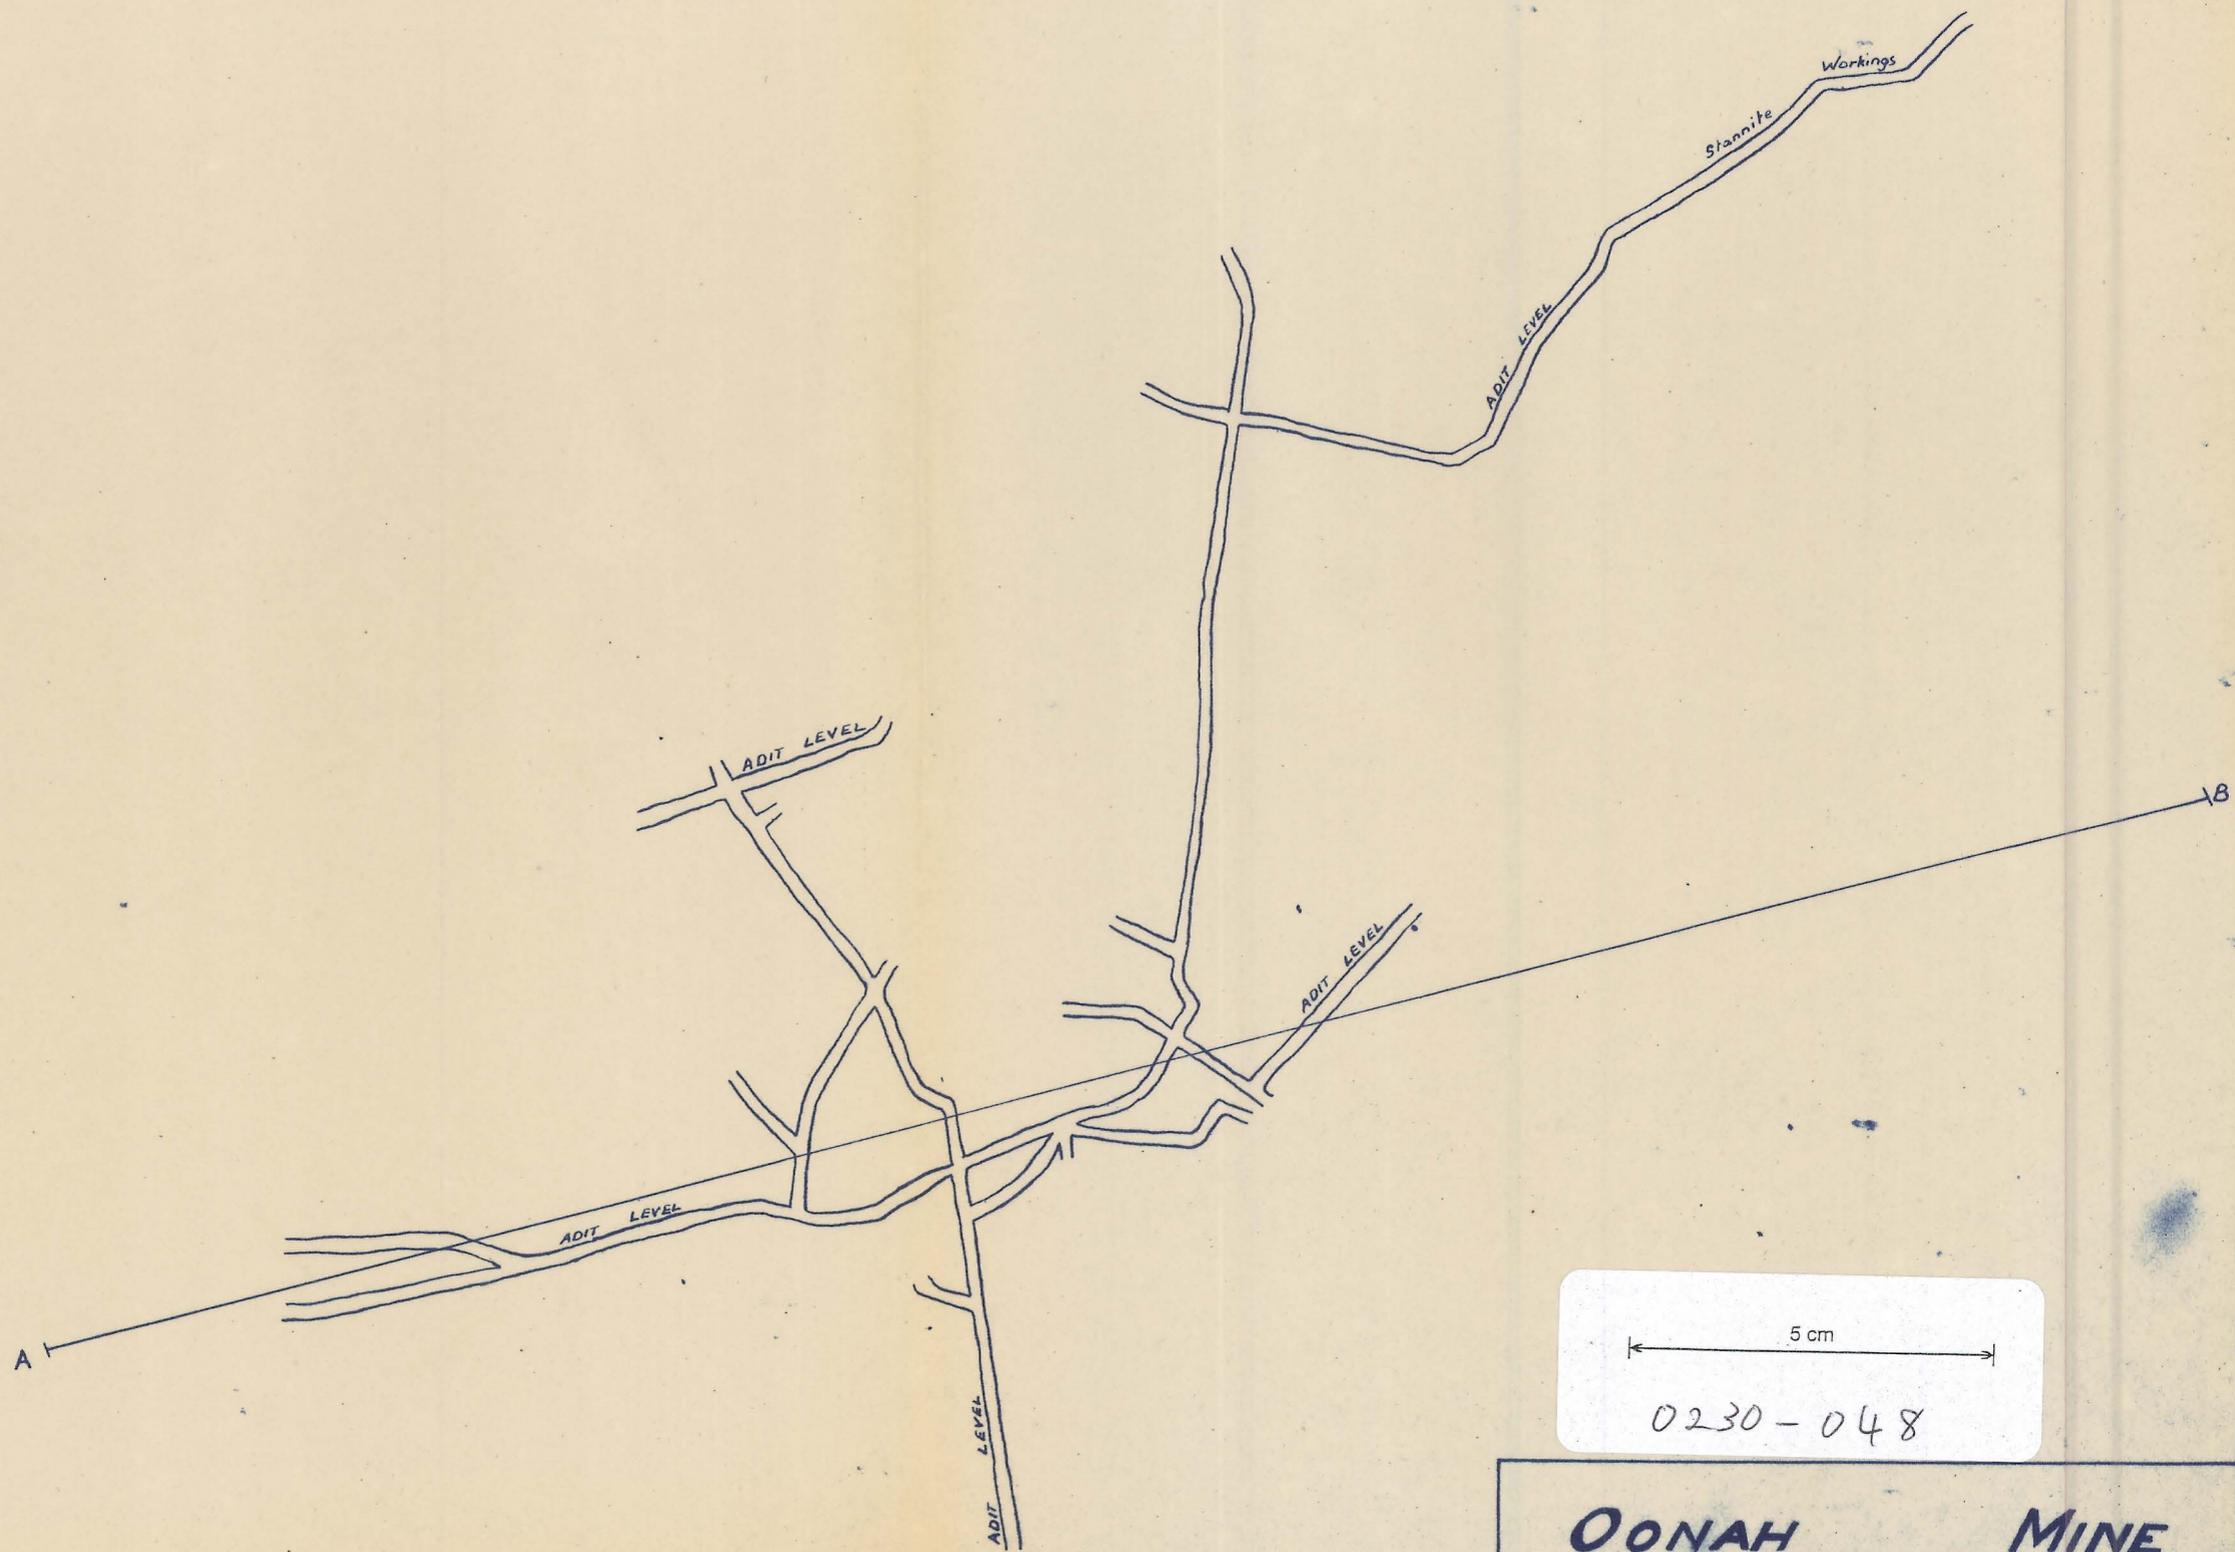

5 cm

0230 - 048

**OONAH MINE**

PLAN

ADIT LEVEL

Scale

50 25 0 50 100 150

N