

N.G.C.  
81  
87 G. 10 ac.

N.G.C.  
82  
87 G. 10 ac.

N.G.C.  
83  
87 G. 10 ac.

N.G.C.  
85  
87 G. 10 ac.

# CROSS SECTION


Scale: 25 Feet to one inch



## PLAN NEW GOLDEN GATE

Scale: 25 Feet to one inch

- Note
- 7' x 310 Feet Level
  - 7' x 8 at 700 do.
  - 7' x 3 at 800 do.
  - 7' x 10 at 900 do.
  - 7' x 11 at 1000 do.
  - 7' x 12 at 1100 do.

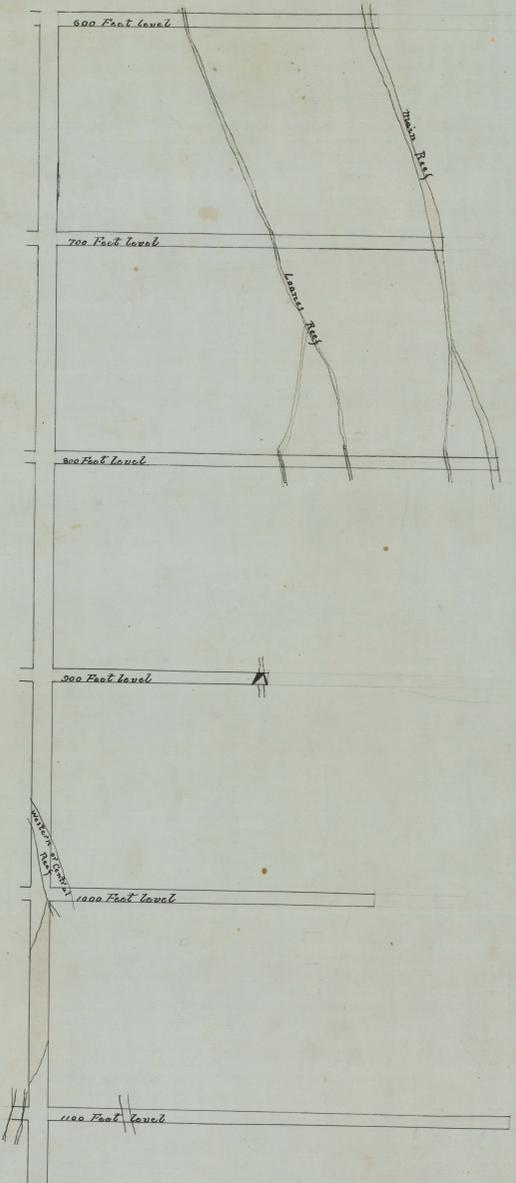

13  
87 G. 10 ac.

531-01

certificat de la Commune  
M. A. B. B.  
Commune de

2-1/197