
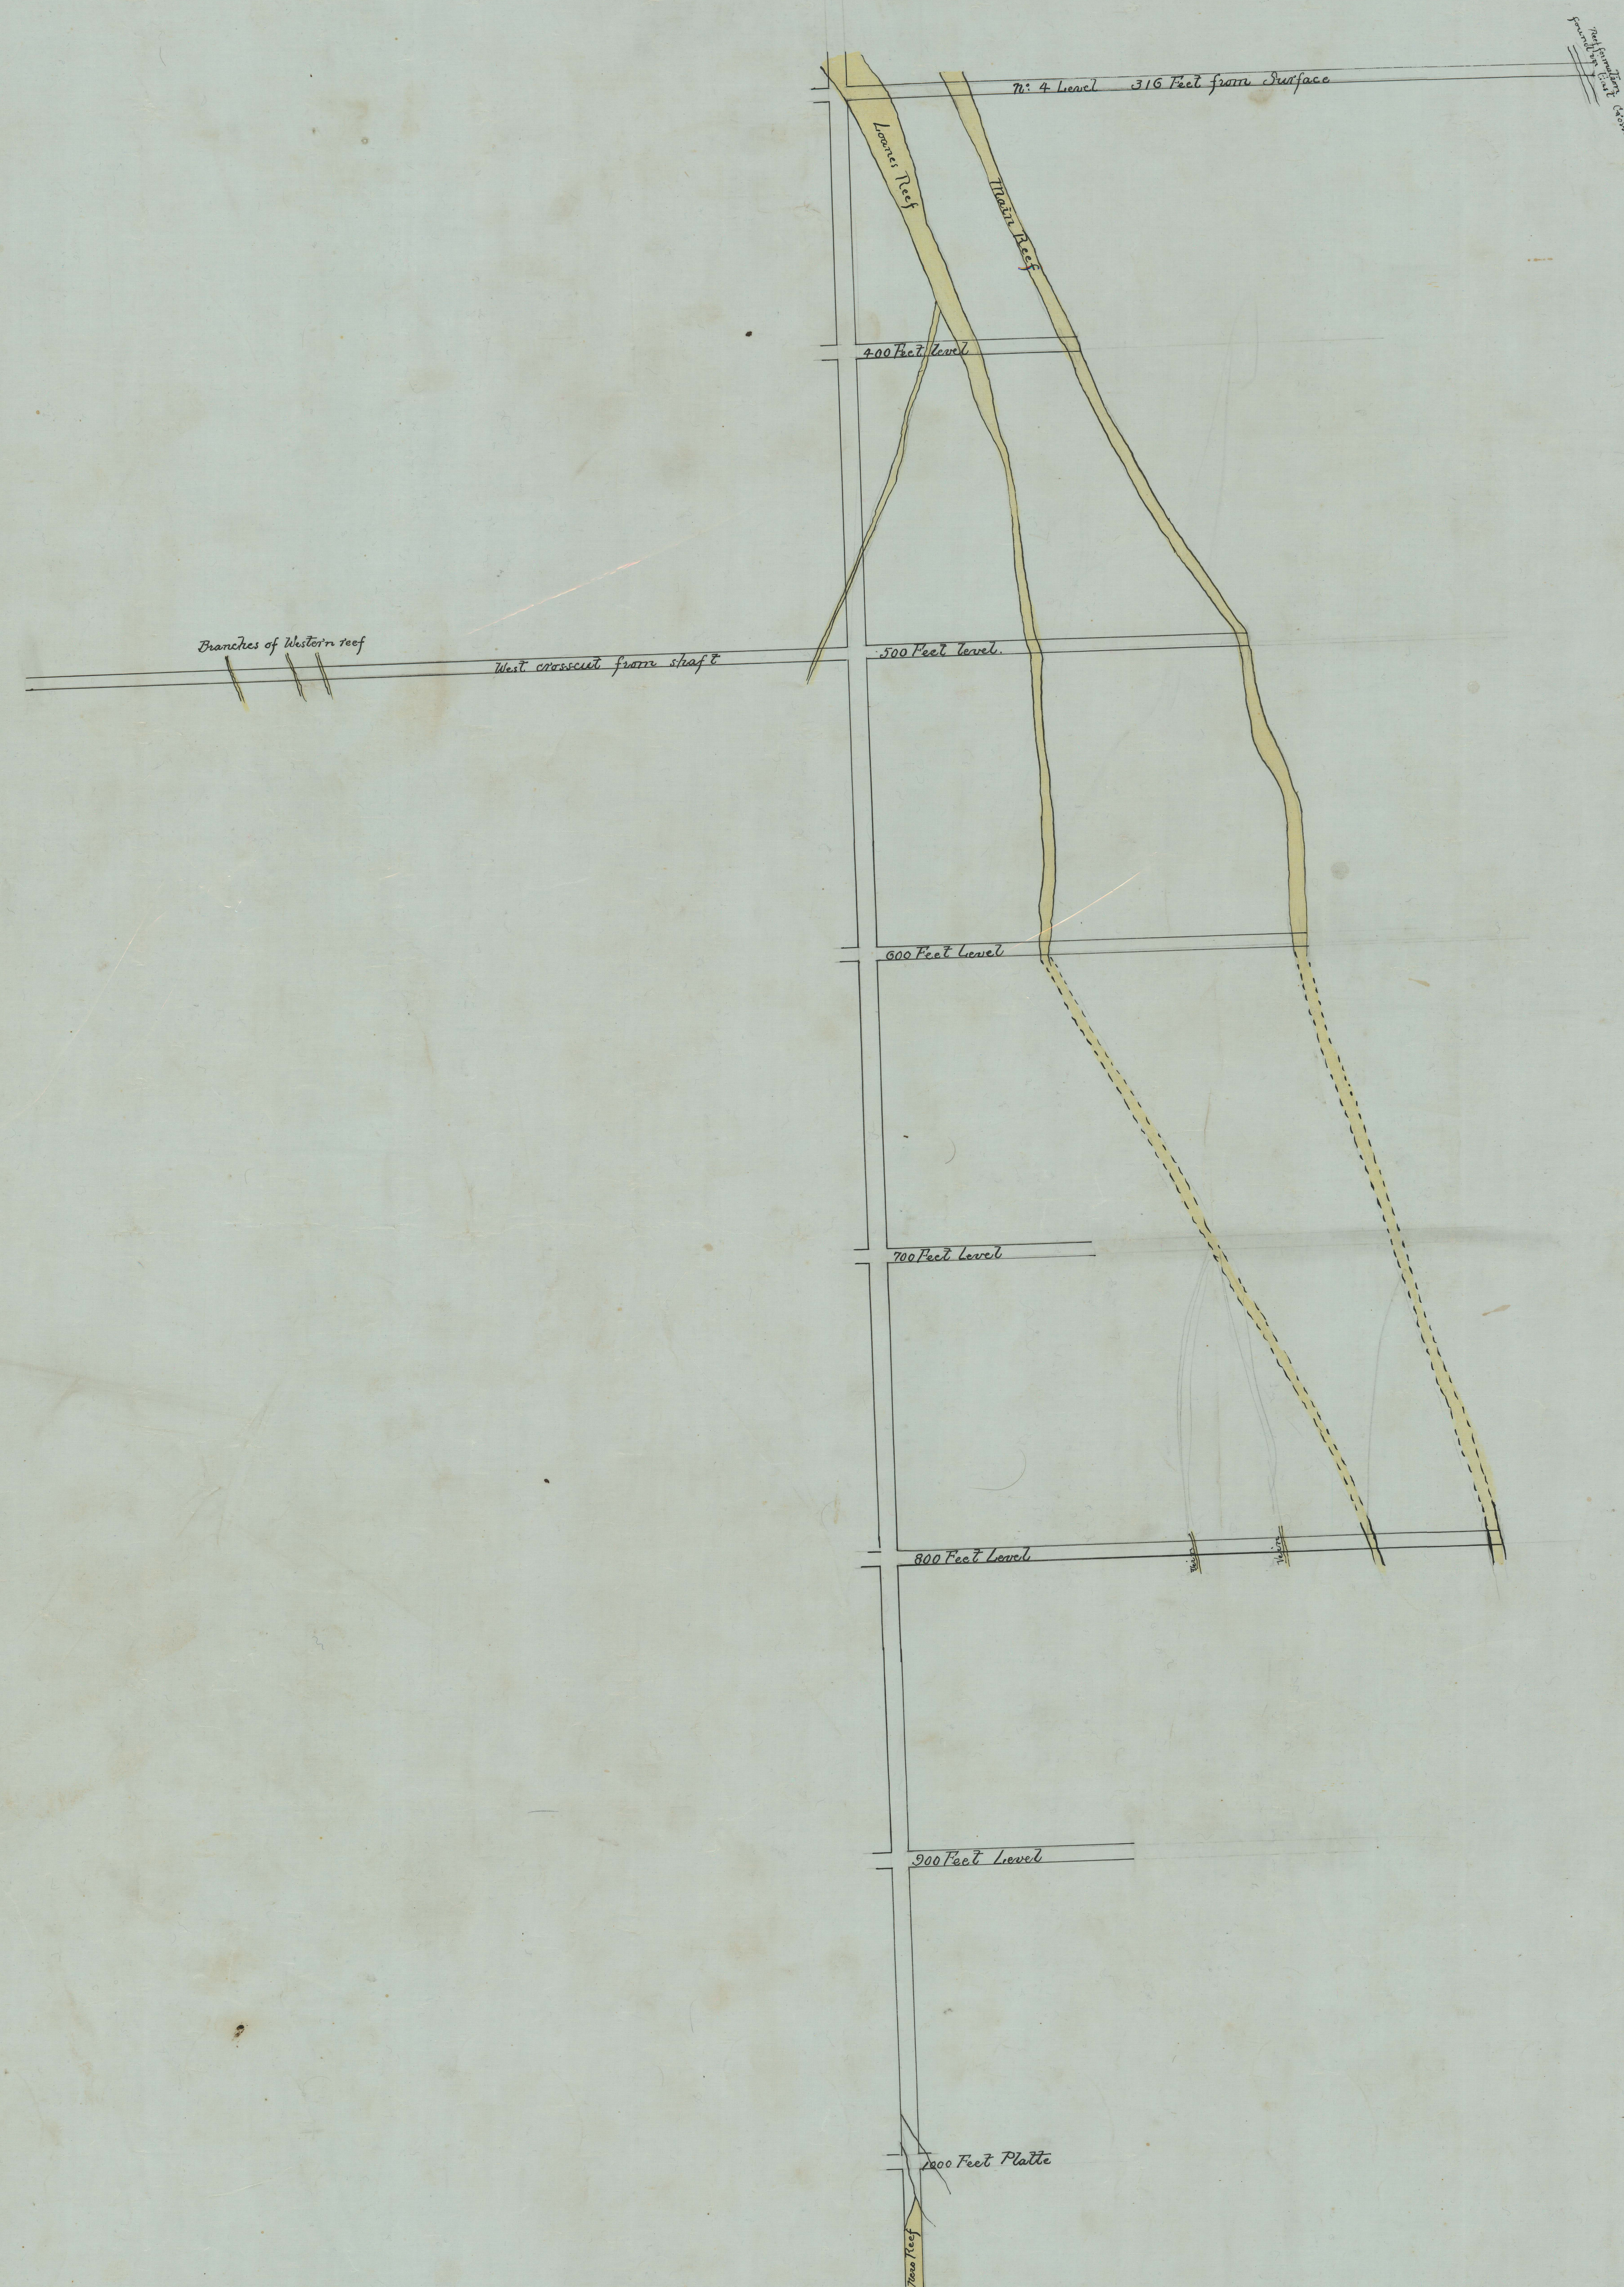


CROSS SECTION

Scale:- 25 Feet to one inch

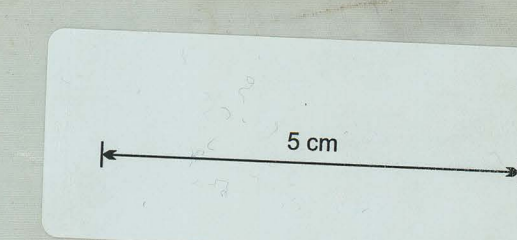

N. & C.
Section 130.
10 ac.

N. & C.
Section 131.
3 ac.

N. & C.
Section 132.
10 ac.

Surveyed with Transit Theodolite

Certified to be correct

Wm. Andrews

Managing Manager

Madison, Dec 14 1895

PLAN OF NEW GOLDEN GATE

Scale:- 25 Feet to one inch



Surface survey from N.W. corner of section 130 to 131

1895-1896