
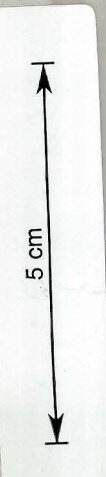


162

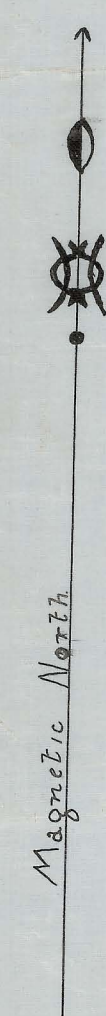

C^T M^T BALFOUR COPPER MINES N.L.


Plan of N^o 1 Adit Level & 150 F^r Level

Scale 40 F^r to 1 Inch.

150 Level surveyed by K.M. Harrison 22 Oct. 1910

N^o 1 Adit Level. . . W.R. Sale 24 Feb 1910

W.R. Sale
Mine Manager

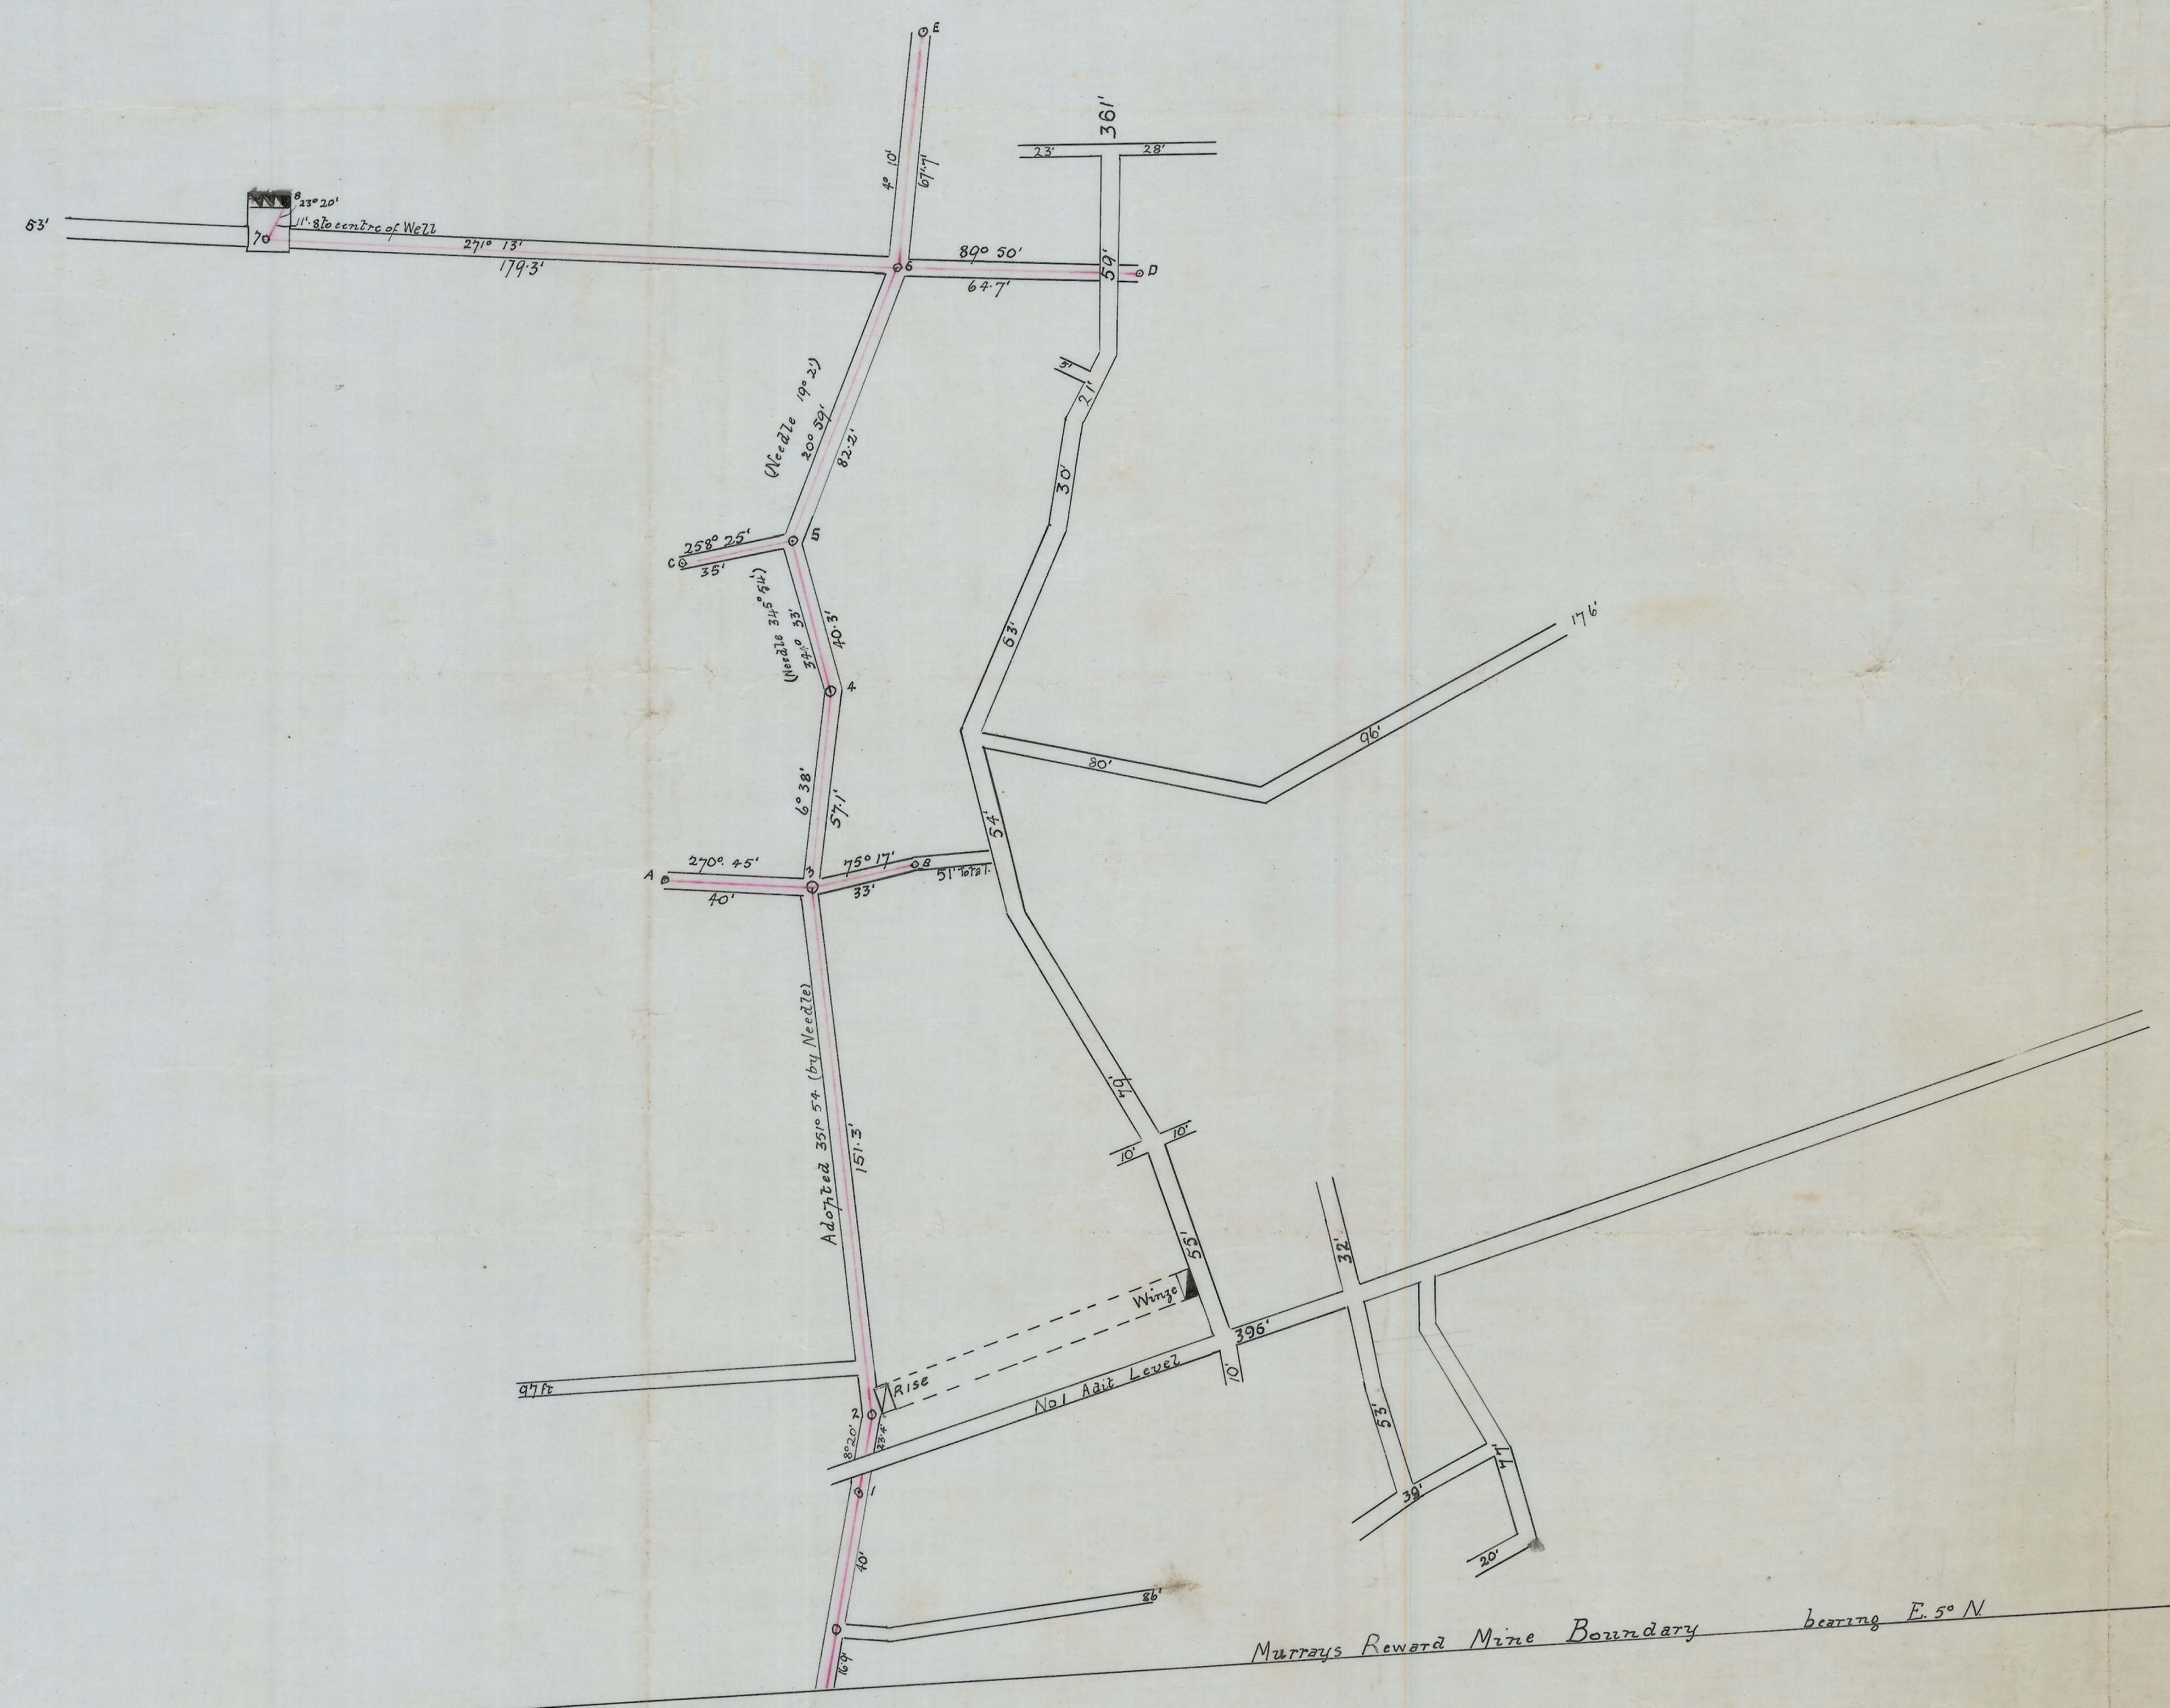

Not Accepted.