


233/p1


# THE NORTH GOLDEN GATE GOLD MINING CO, MATHINNA

## working plan

scale, one inch = 25 feet.

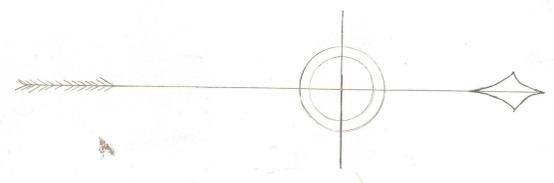

70  
875

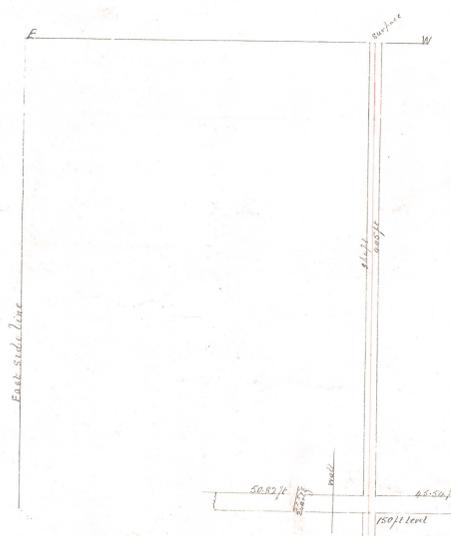

Survey made with a silver dial by Davis and son Derby England  
Traverse lines 150 feet are in black, 392 feet in red and  
measurements made with a standard of standard length - Links  
being reduced to feet. J. M. Potter

