
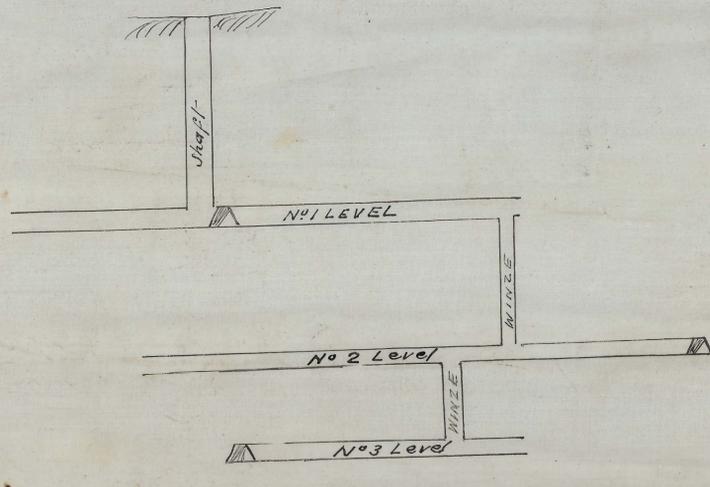
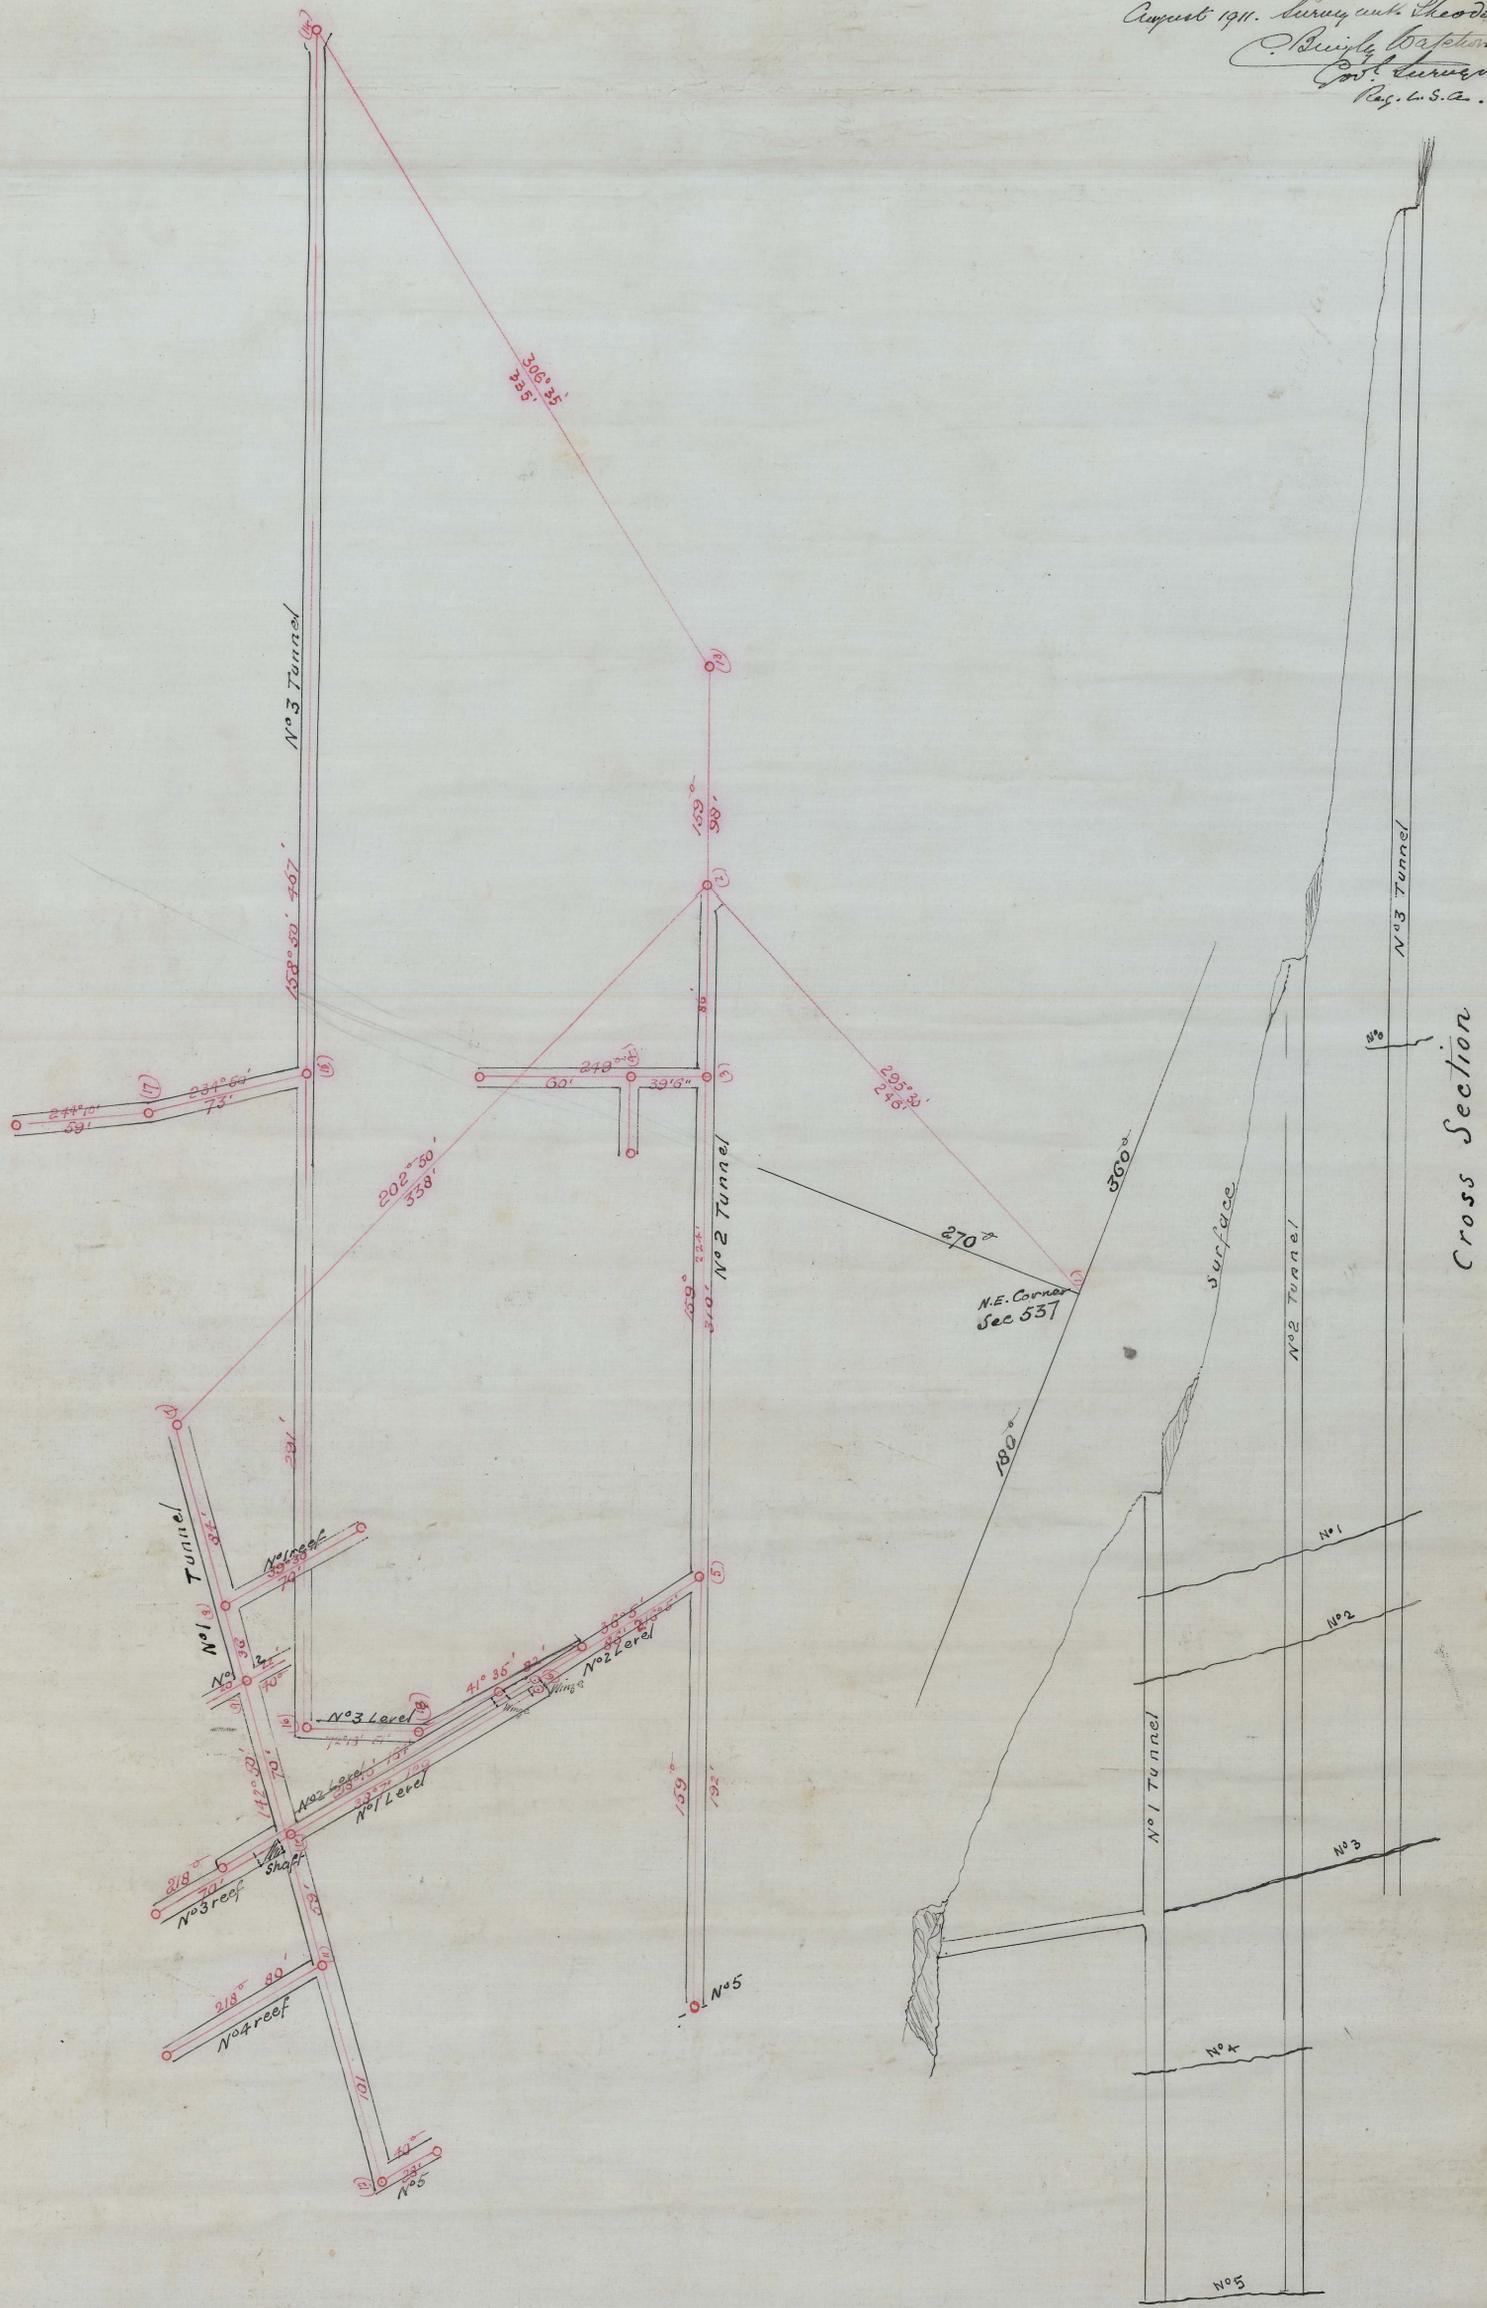


NEW PANAMA C.M.

Scale 40 ft. to 1 inch

Certified copy of work done to August 1911. Survey with theodolite
C. B. Wright
Civil Engineer
Panama, C. Z. C.

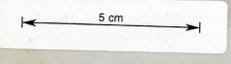

Handwritten notes and signatures in the bottom right corner.