

5 cm

226-01

# COLDEN GATE CON<sup>TD</sup>N.L

## MATHINNA


REFERENCE PLAN OF ACTIVE WORK

SCALE 1"=30'

THE MINE

H. H. Miller  
Mine Manager 10.4.1924

NORTH GATE

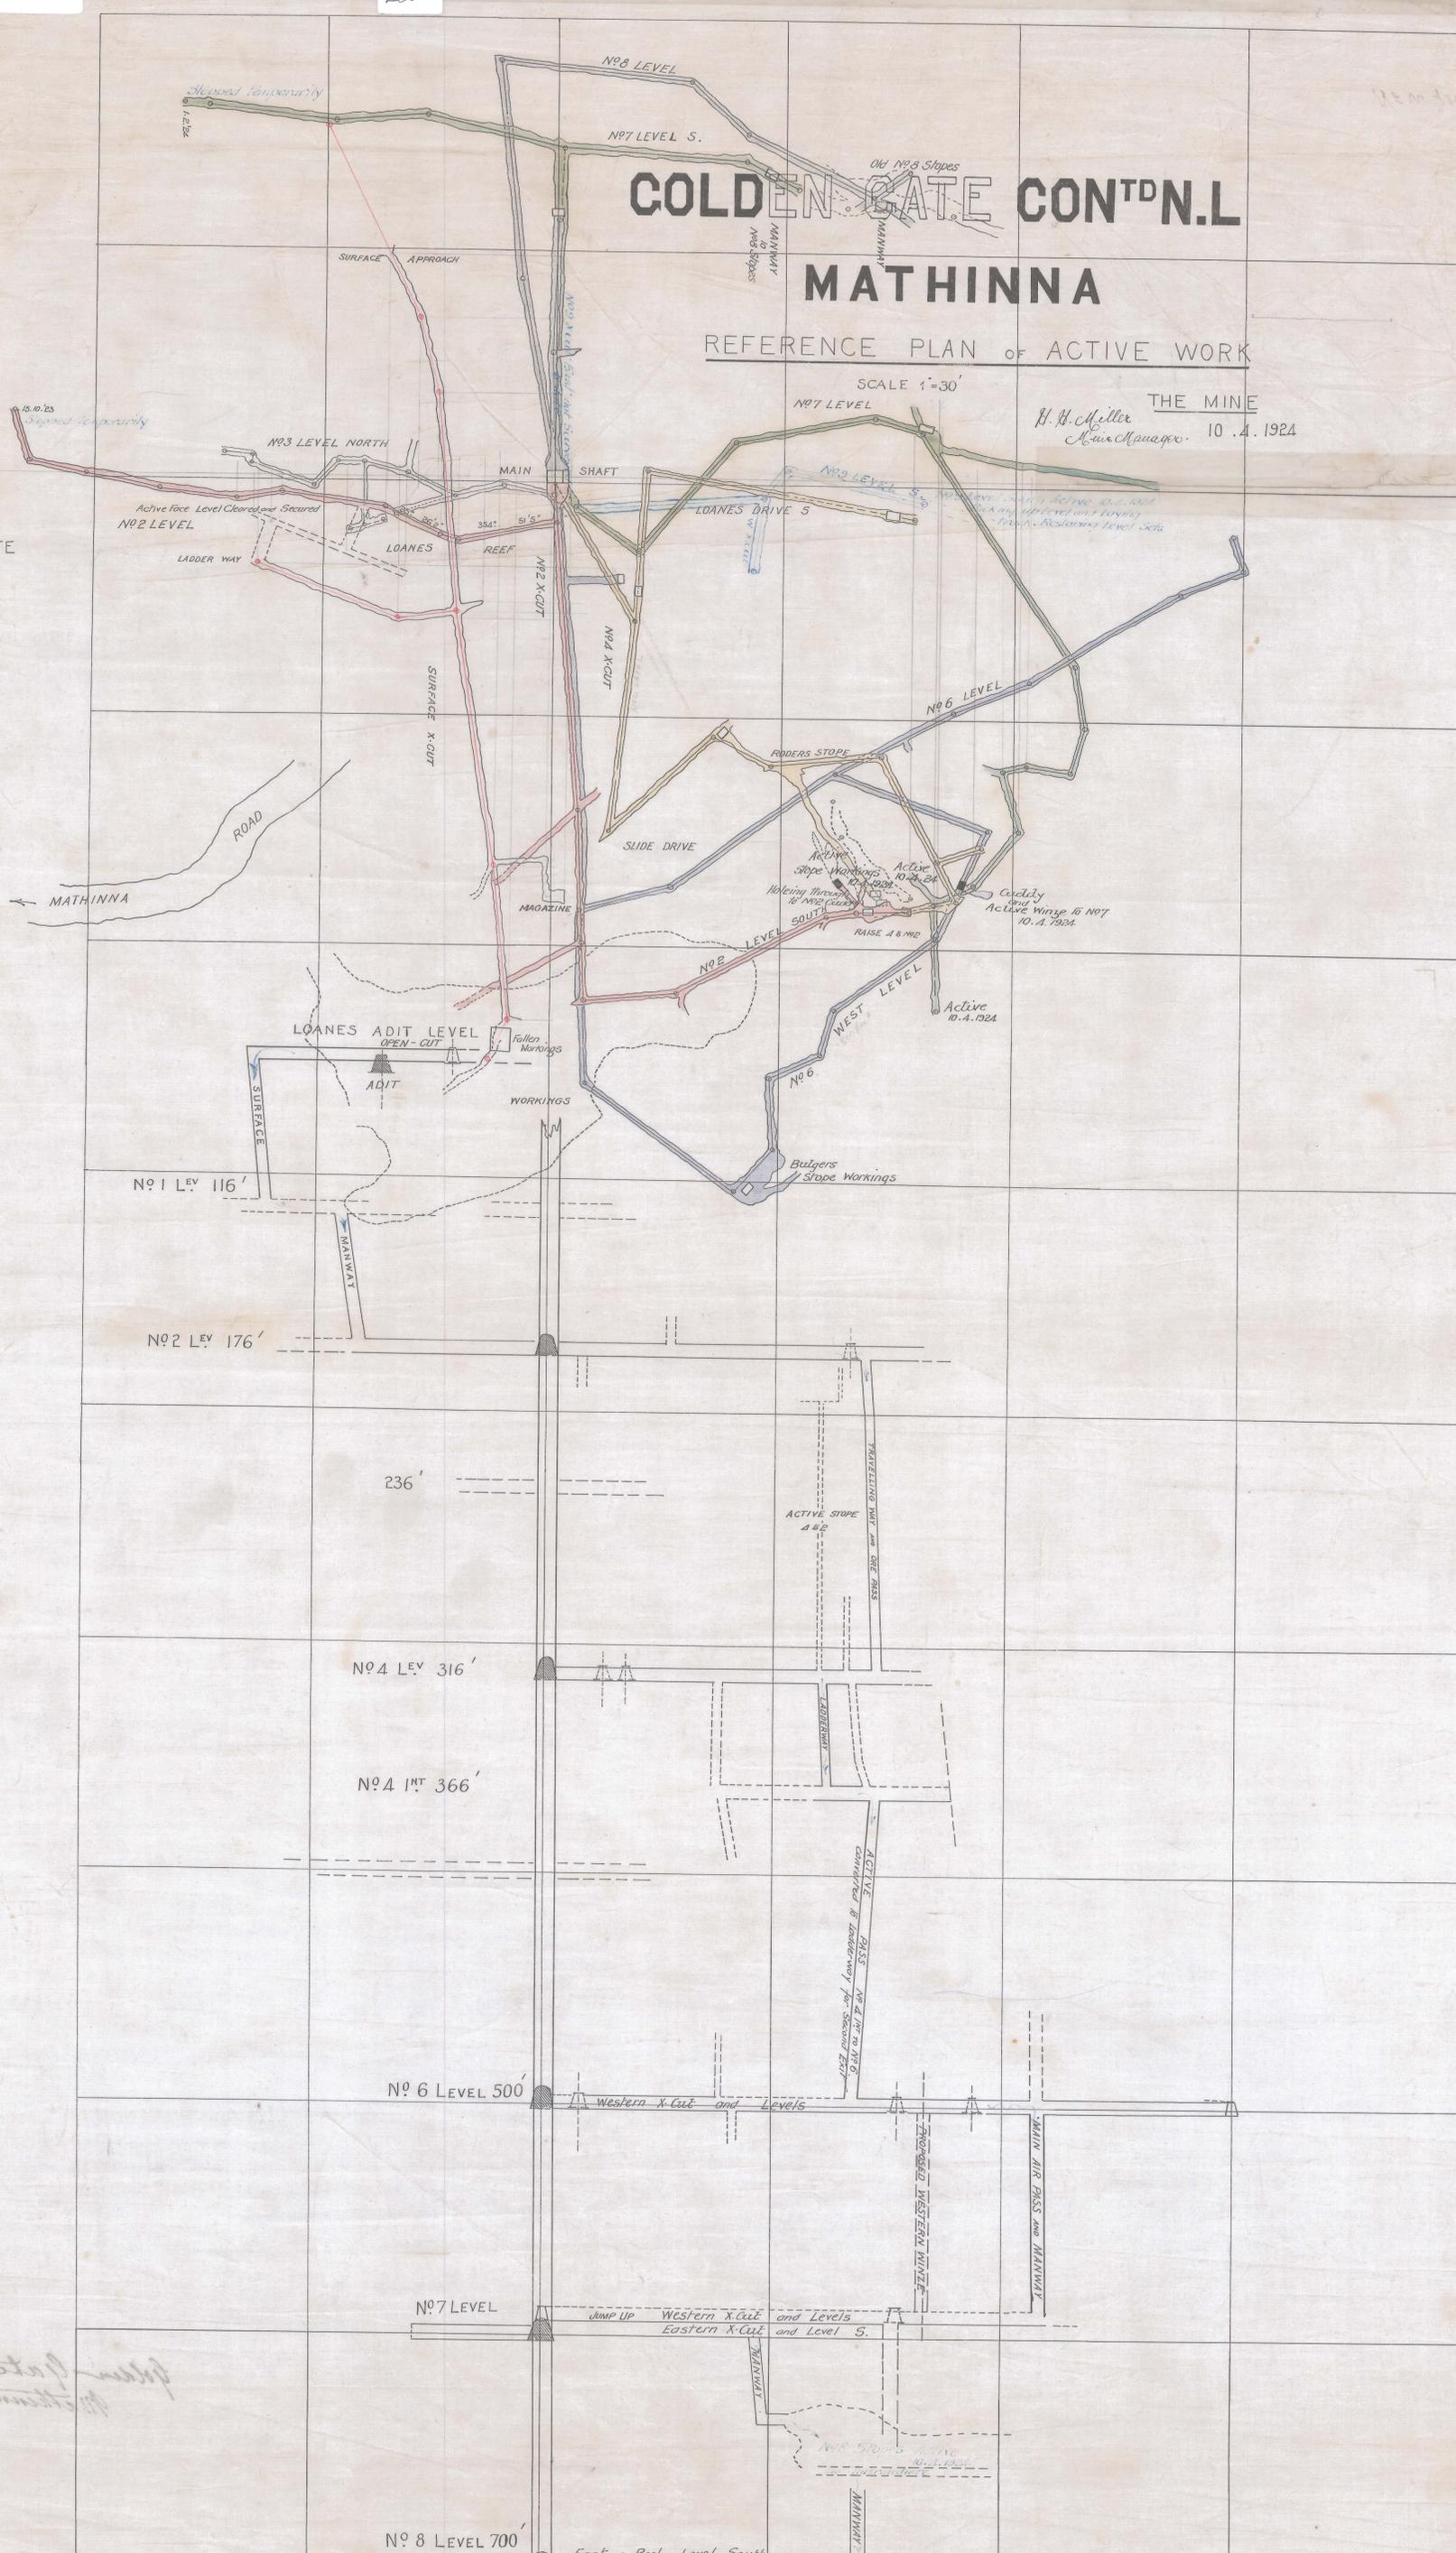

No. 9 Level South being picked up and Secured at this date

East X-Cut and Level on Eastern Reef not required at this date

Mine Water Level approx. at 30' below No. 9 Baling 1 Shift