


236-04

NEW GOLDEN GATE
(OBRIENS MINE)
SOUTH MT VICTORIA

Scale 25 Feet to one inch

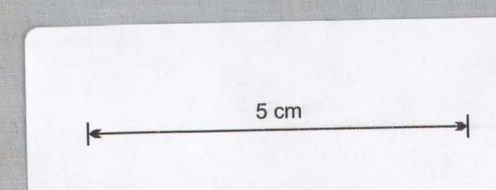

SECTION LOOKING NORTH

Surveyed with Transit theodolite
February 6th 1911

S. J. Andrew
Mining Manager