


The Curtin-Davis Mining Co. No. 2 of The Curtin-Davis Extended Mining Co. No. 2.
 North East Dundas - Tasmania

Longitudinal Section of Lode showing the Tunnels driven to Feb. 4 29th 1896.

Facing Easterly and Square with the Strike of the Lode.

Chas. Montezuma
Surveyor

Scale 440 feet to an Inch.

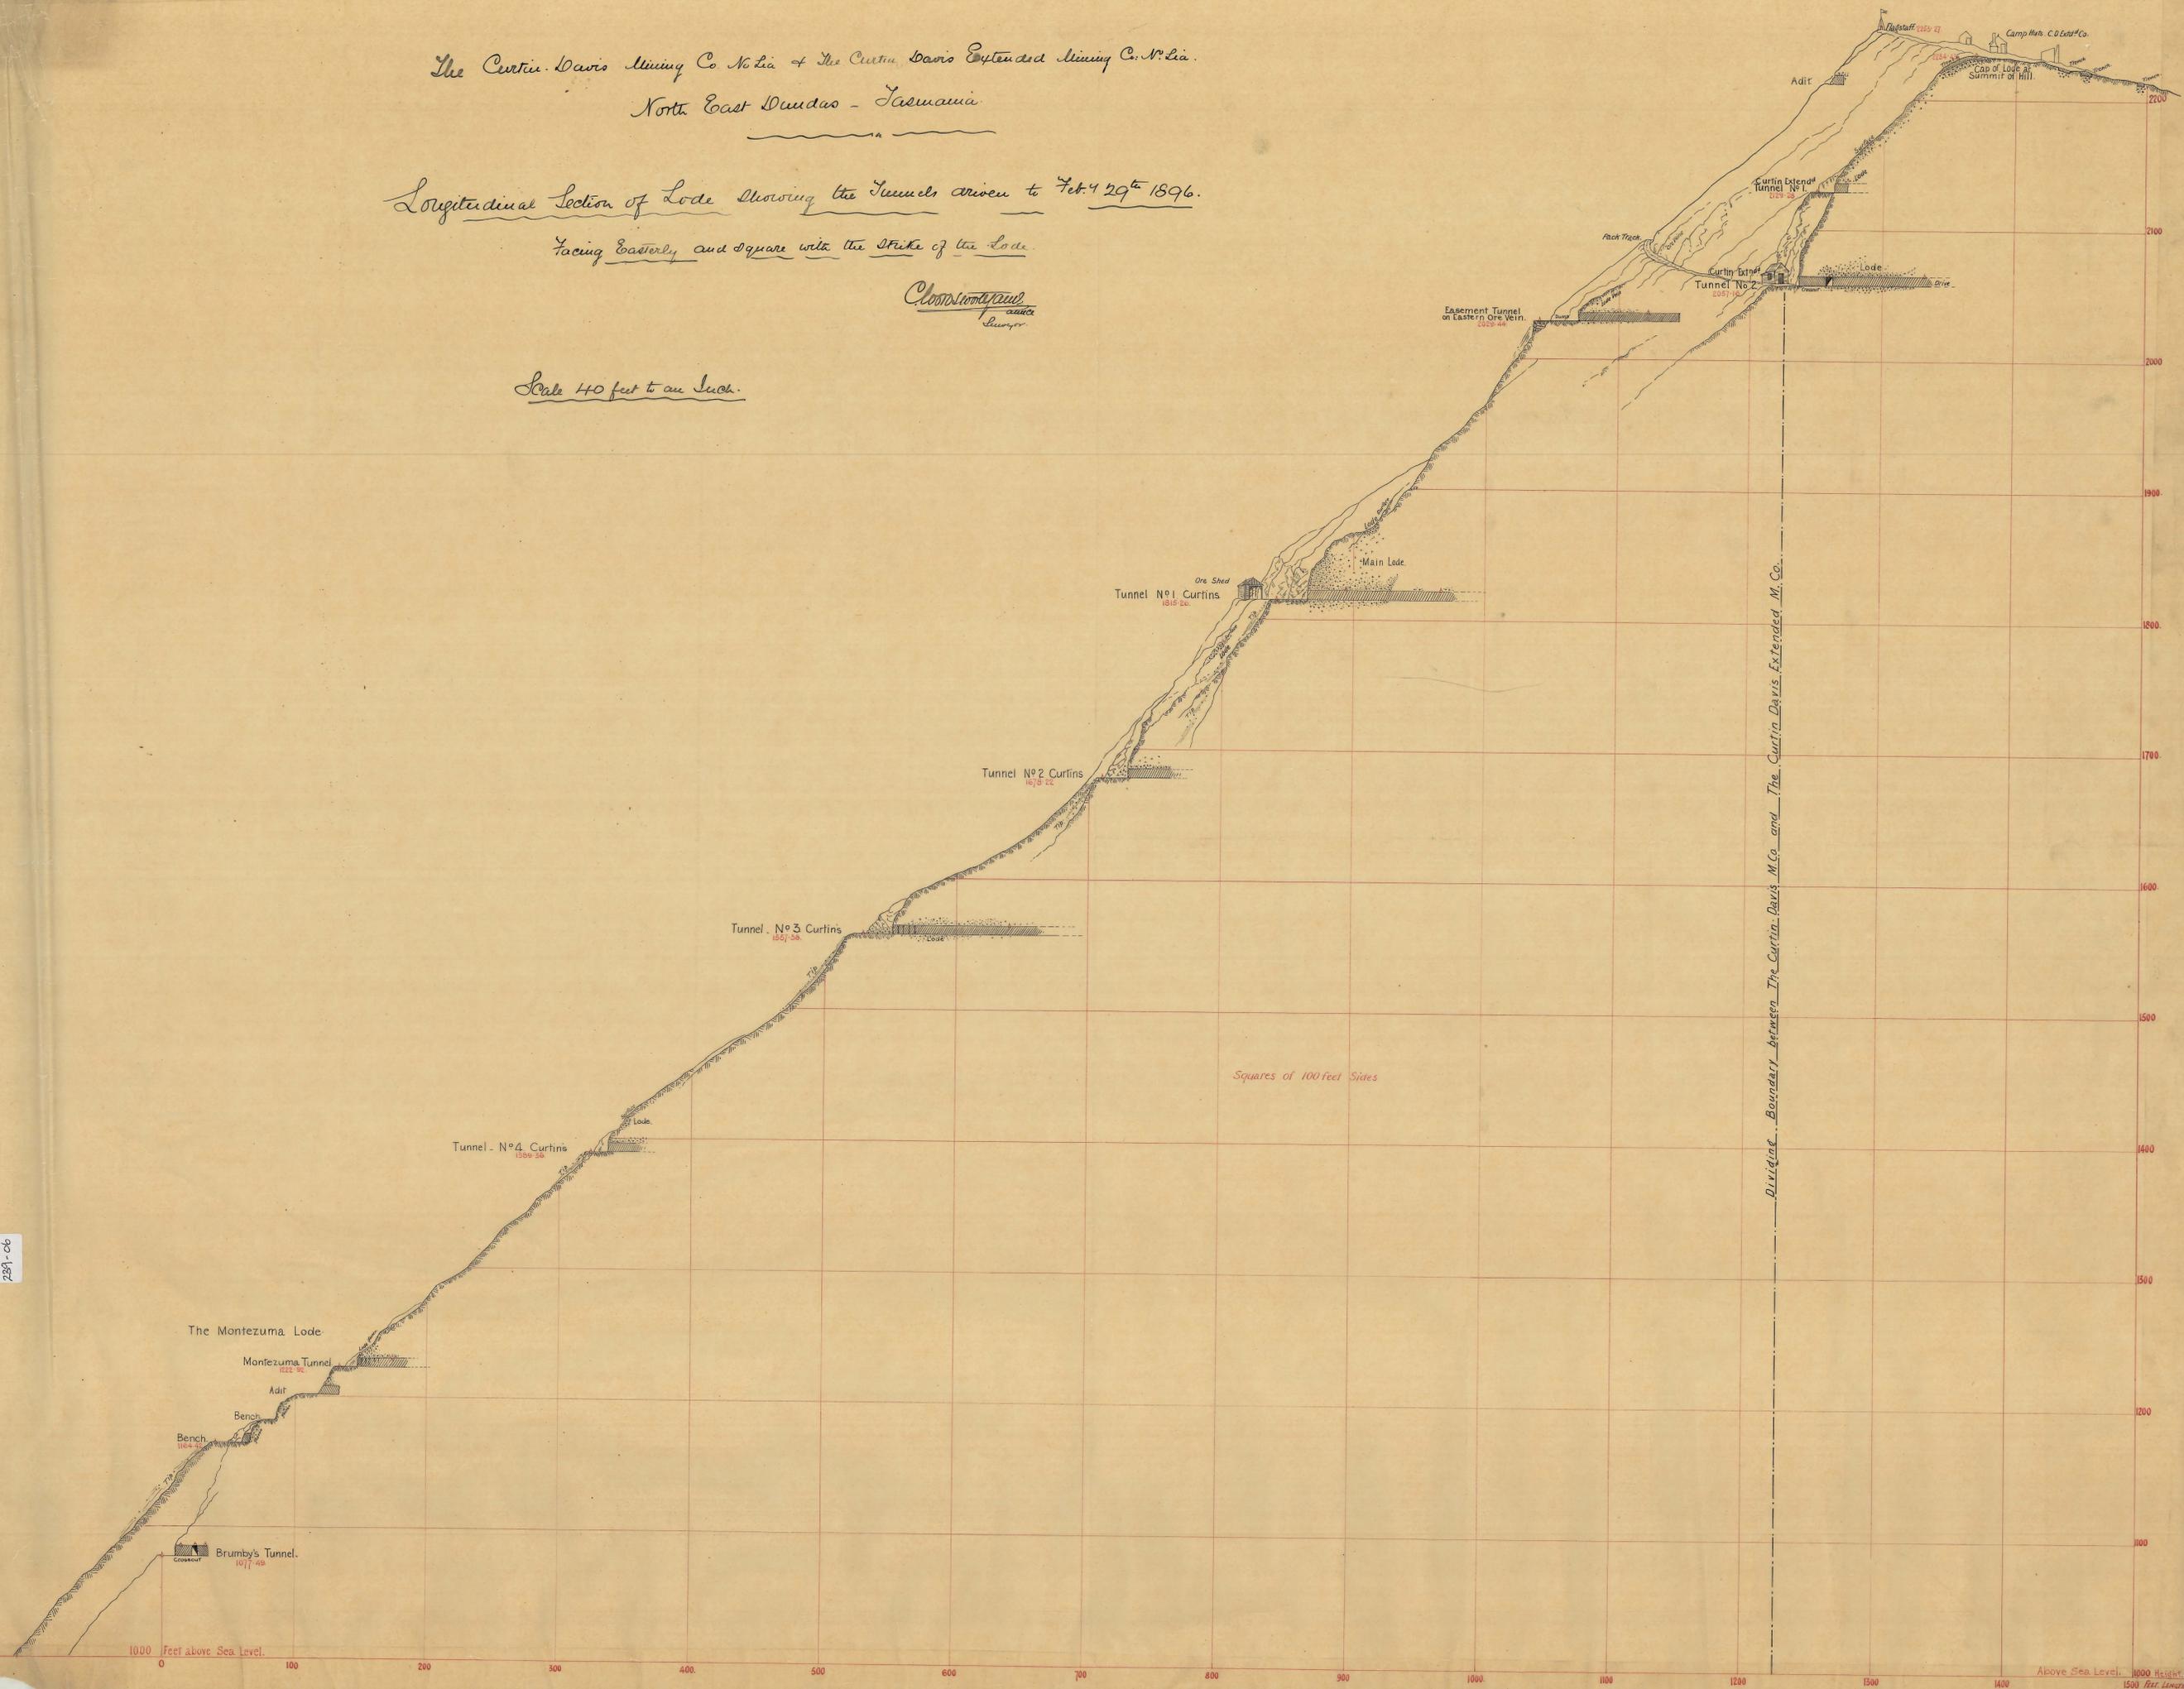

239-06
 239-07
 239-08

500
 239-06

STATE OF TASMANIA
 1896

Above Sea Level. 1000 Height. 1500 Feet Length.