

5 cm


240-01

NO 1 CURTIN & DAVIS SILVER & COPPER MINING CO.



246 SECTION

SCALE 25 ft to An Inch

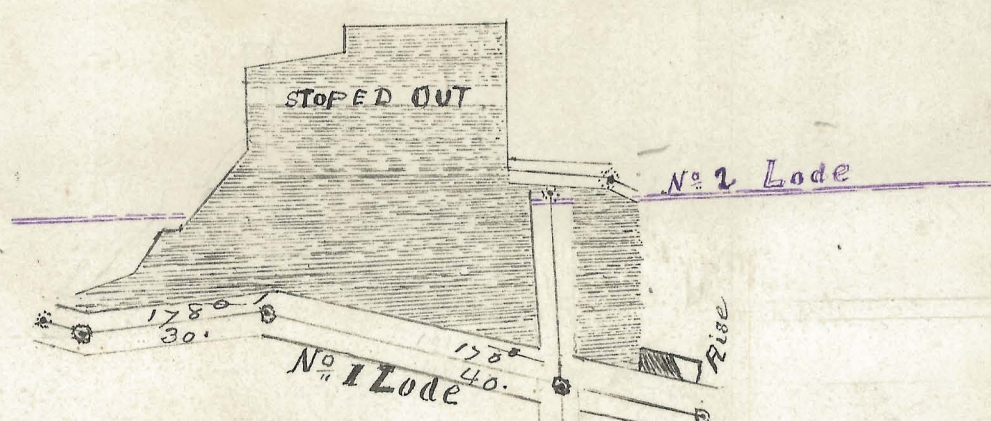


Plan of MINE



Longitudinal SECTION

Surface of Ground

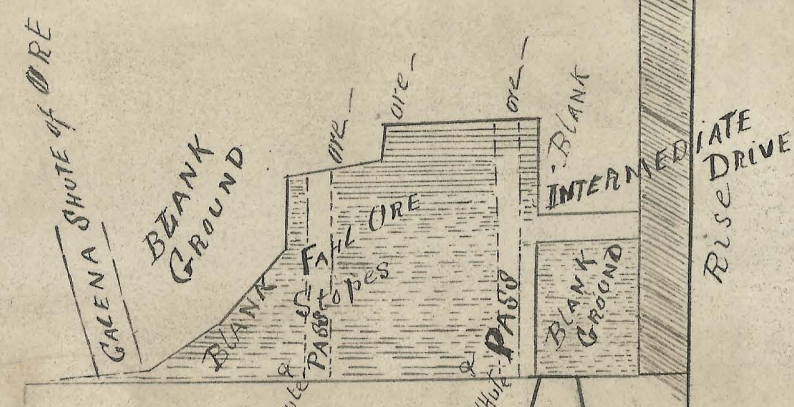

Driven 70ft South of Crosscut.

Driven 20ft North of Crosscut.

98.30
17.9

89.30
148.9

87.10
107.2

88.30

49.6

2.1

80 ft off