

241-01



241-01

N O R T H E R N B O U N D A R Y

89° 51' 1396



# PLAN OF UNDERGROUND WORKINGS. SECTION 667 M. ZEEHAN.

SCALE 40 FEET to 1 INCH.



E A S T E R N B O U N D A R Y

179° 32' 2465

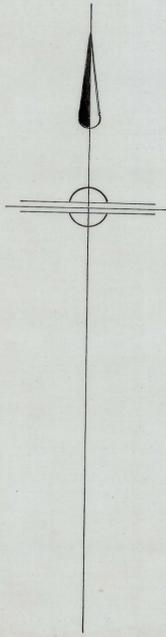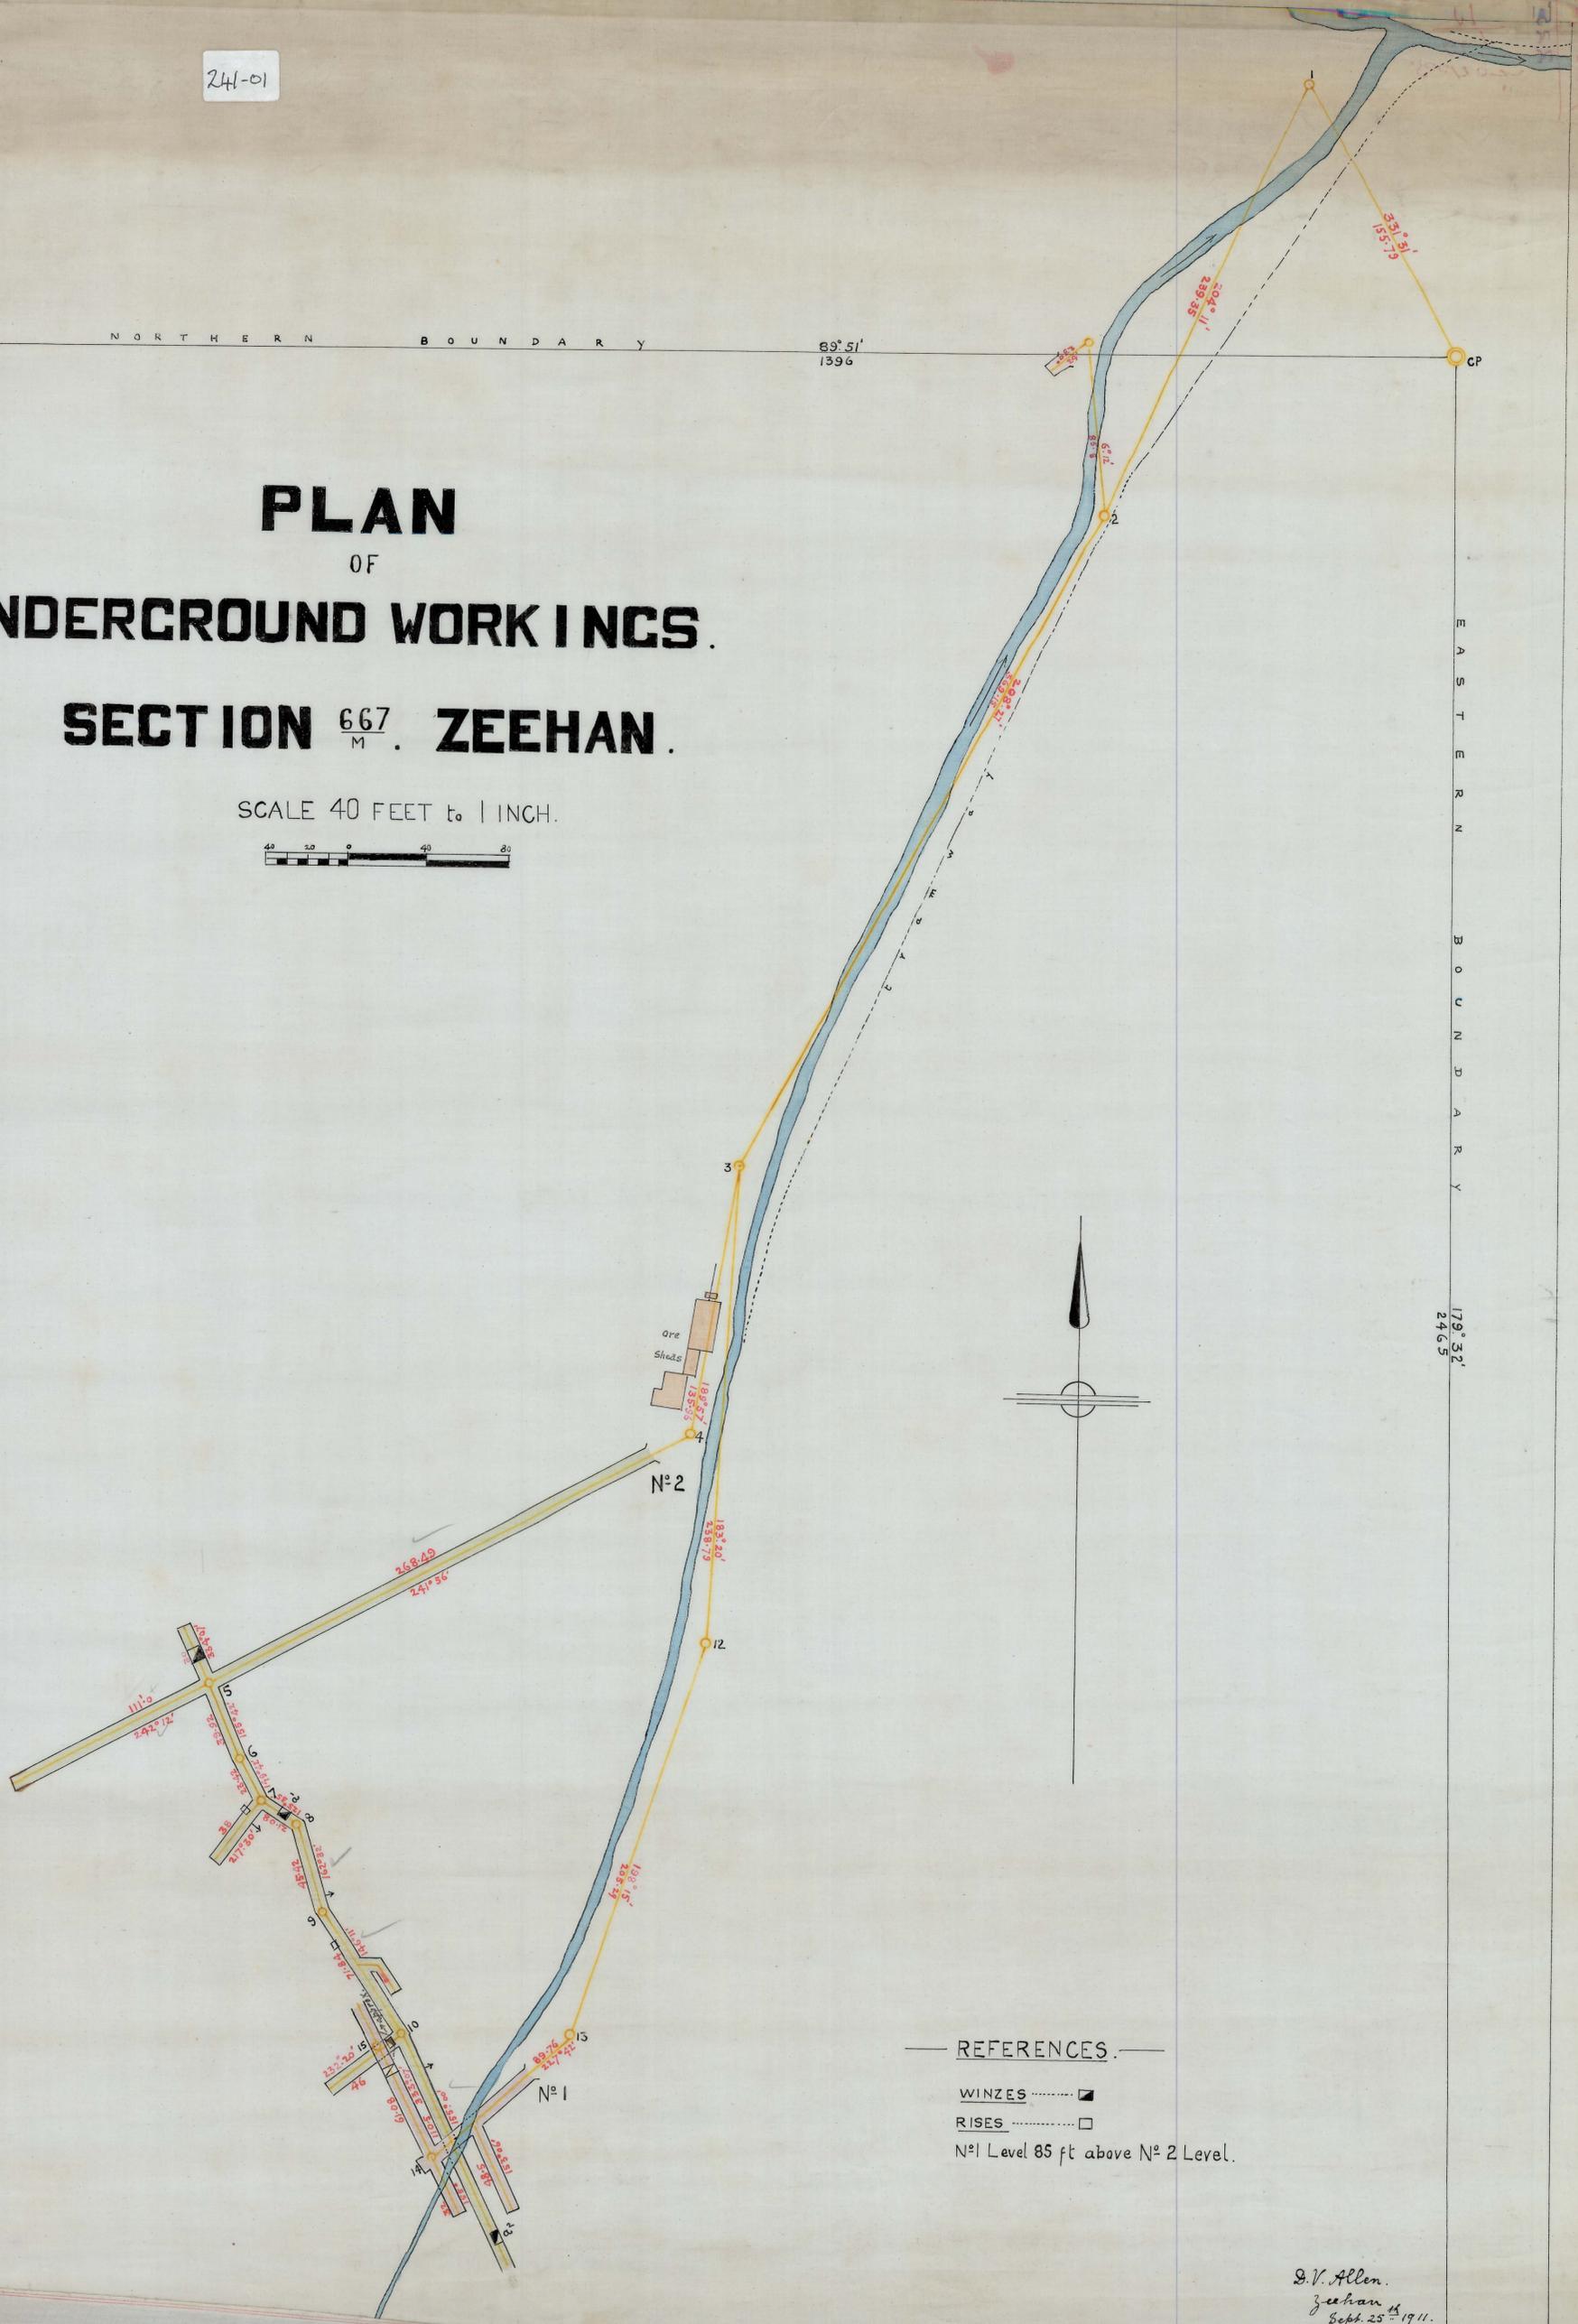

- REFERENCES.
- WINZES
  - RISES
- N° 1 Level 85 ft above N° 2 Level.

D. V. Allen.  
Zeehan  
Sept. 25 1911.