

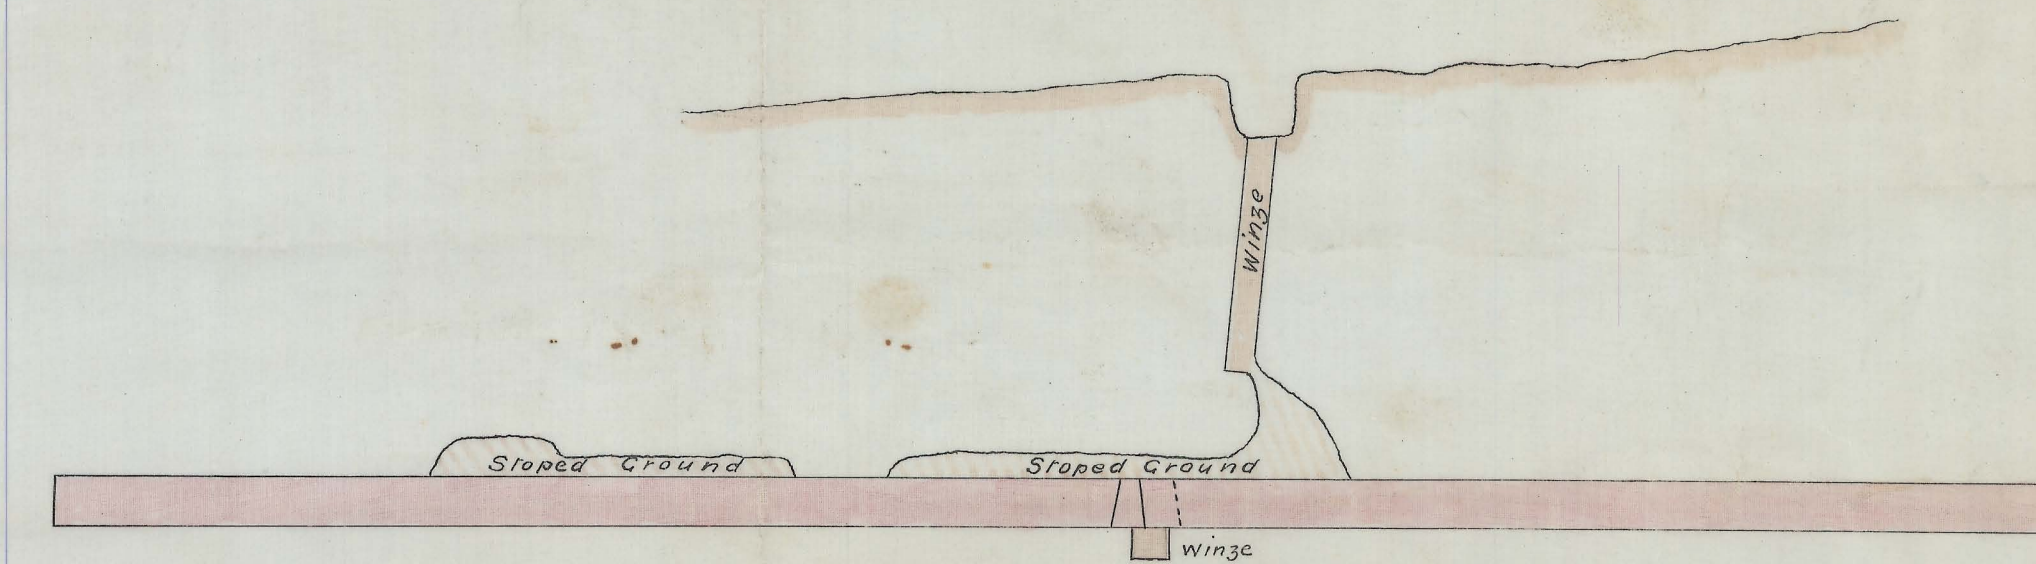


242-02

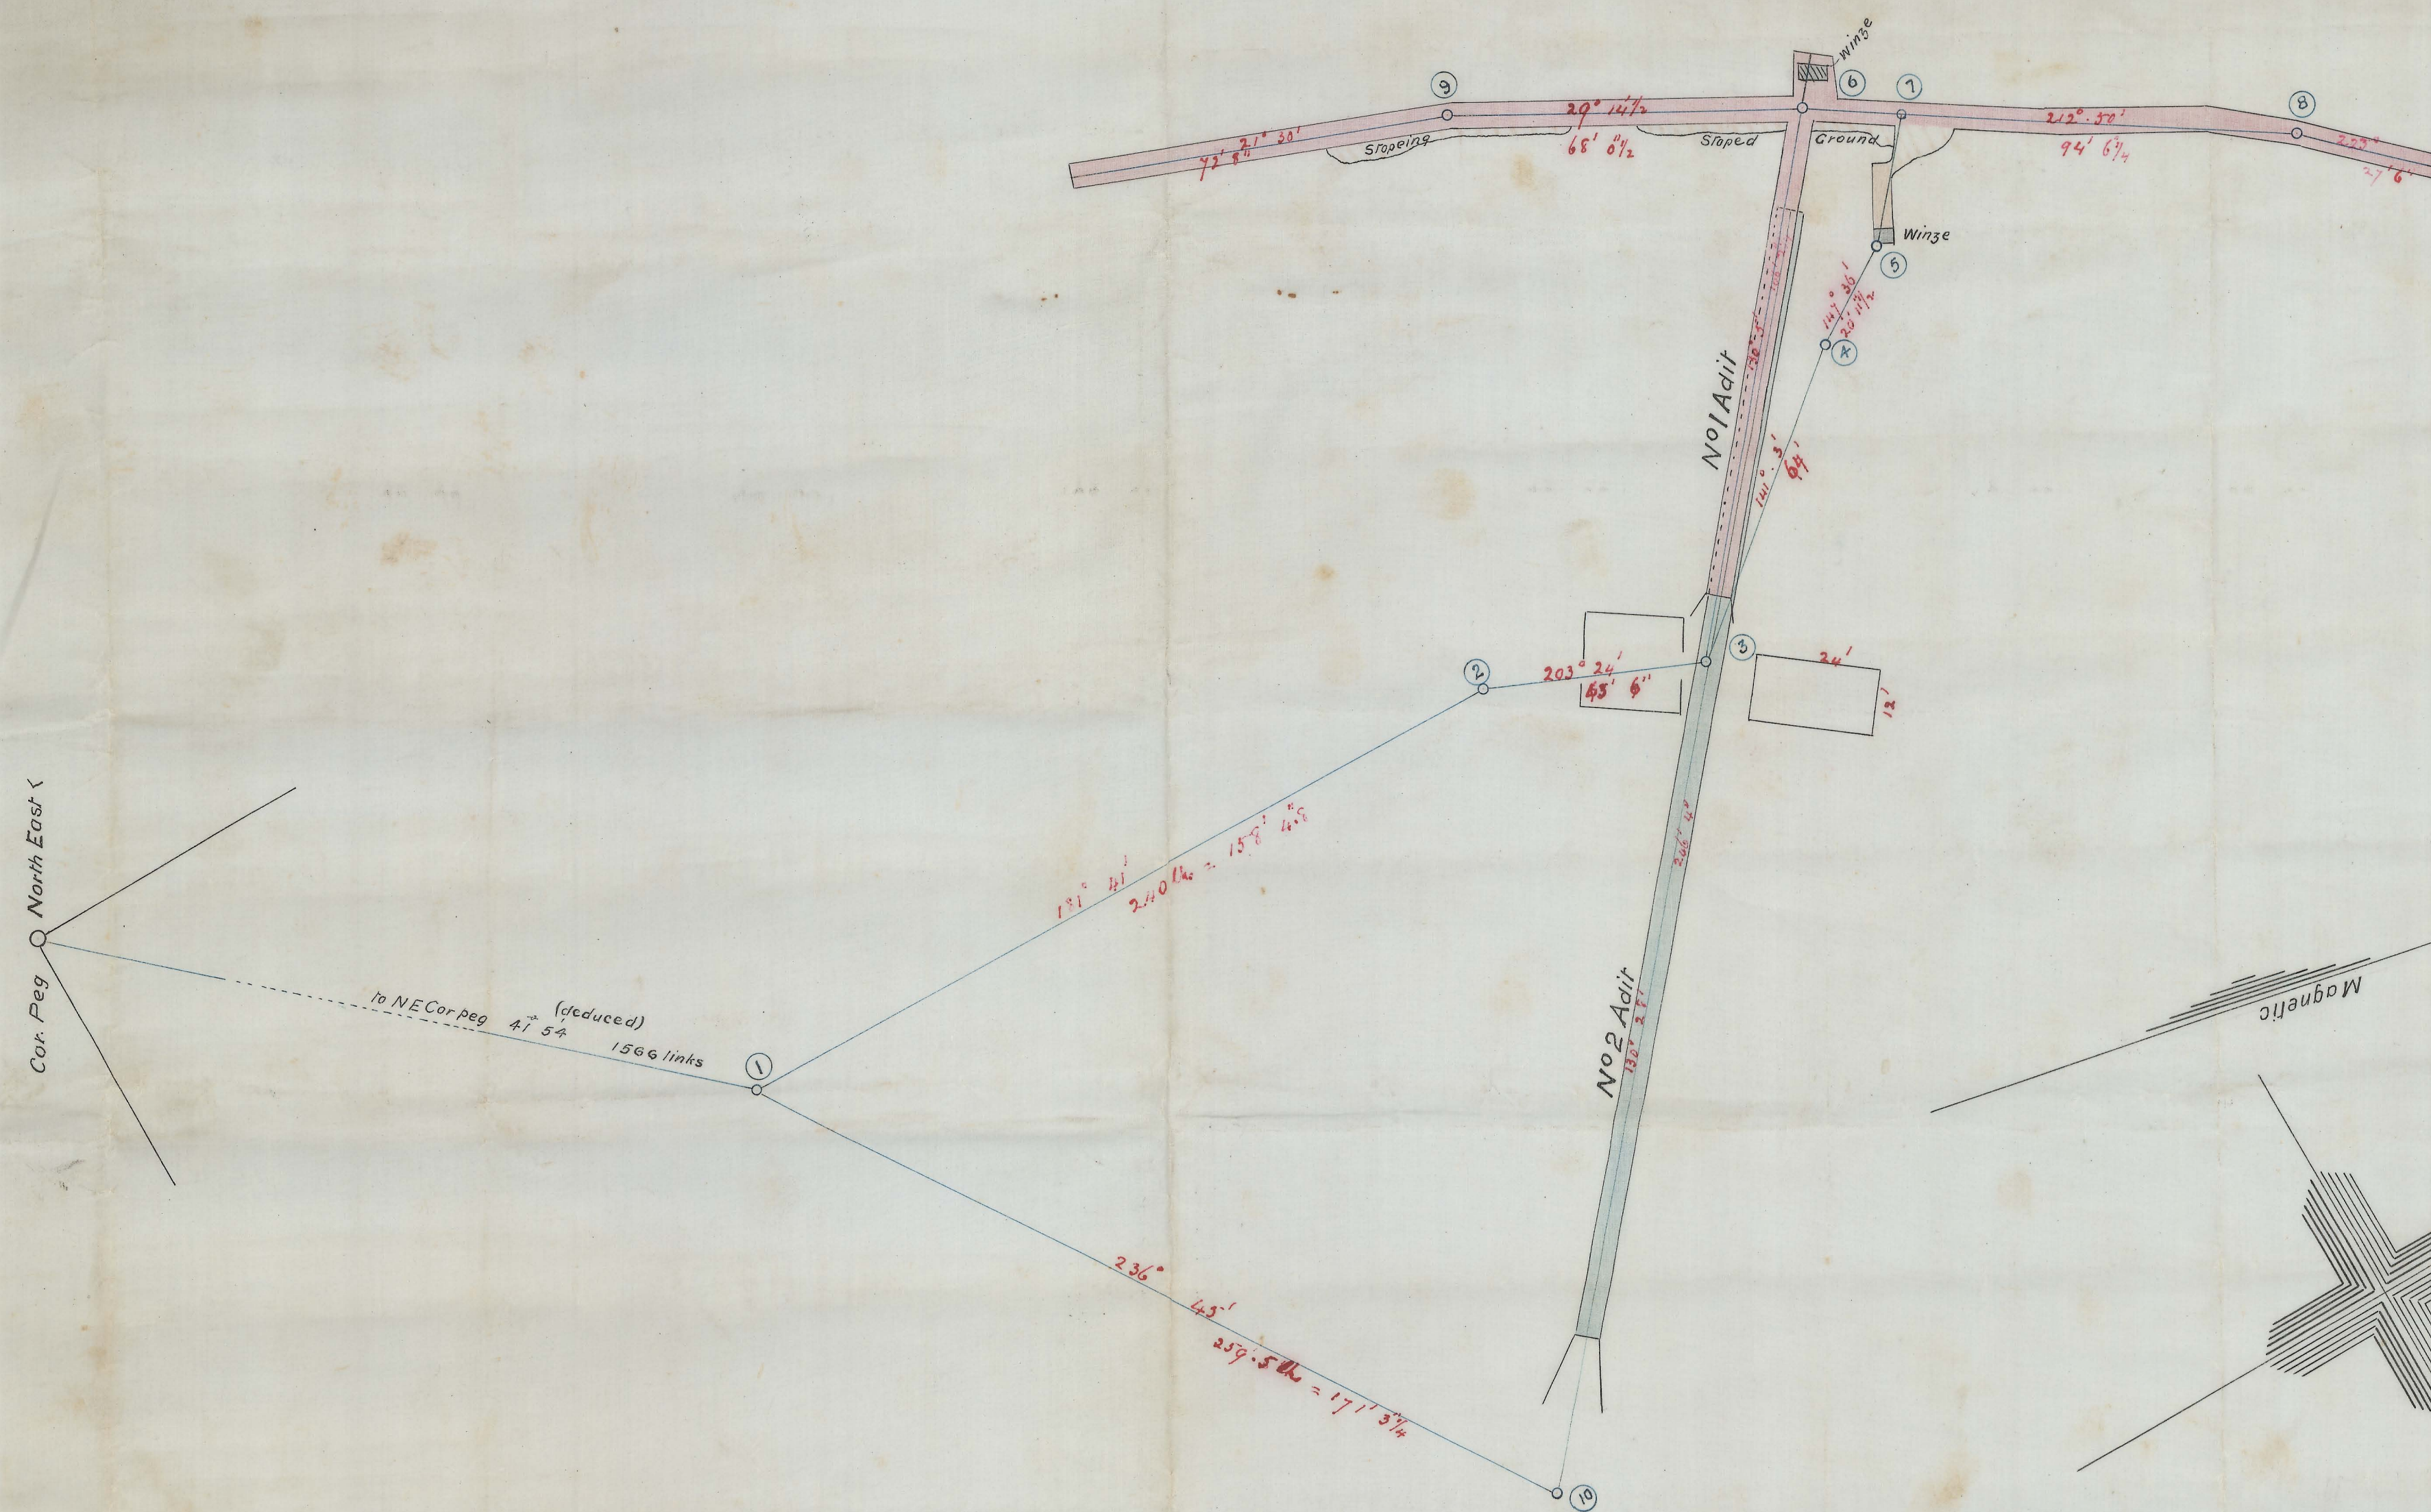

SECTION ON LODGE

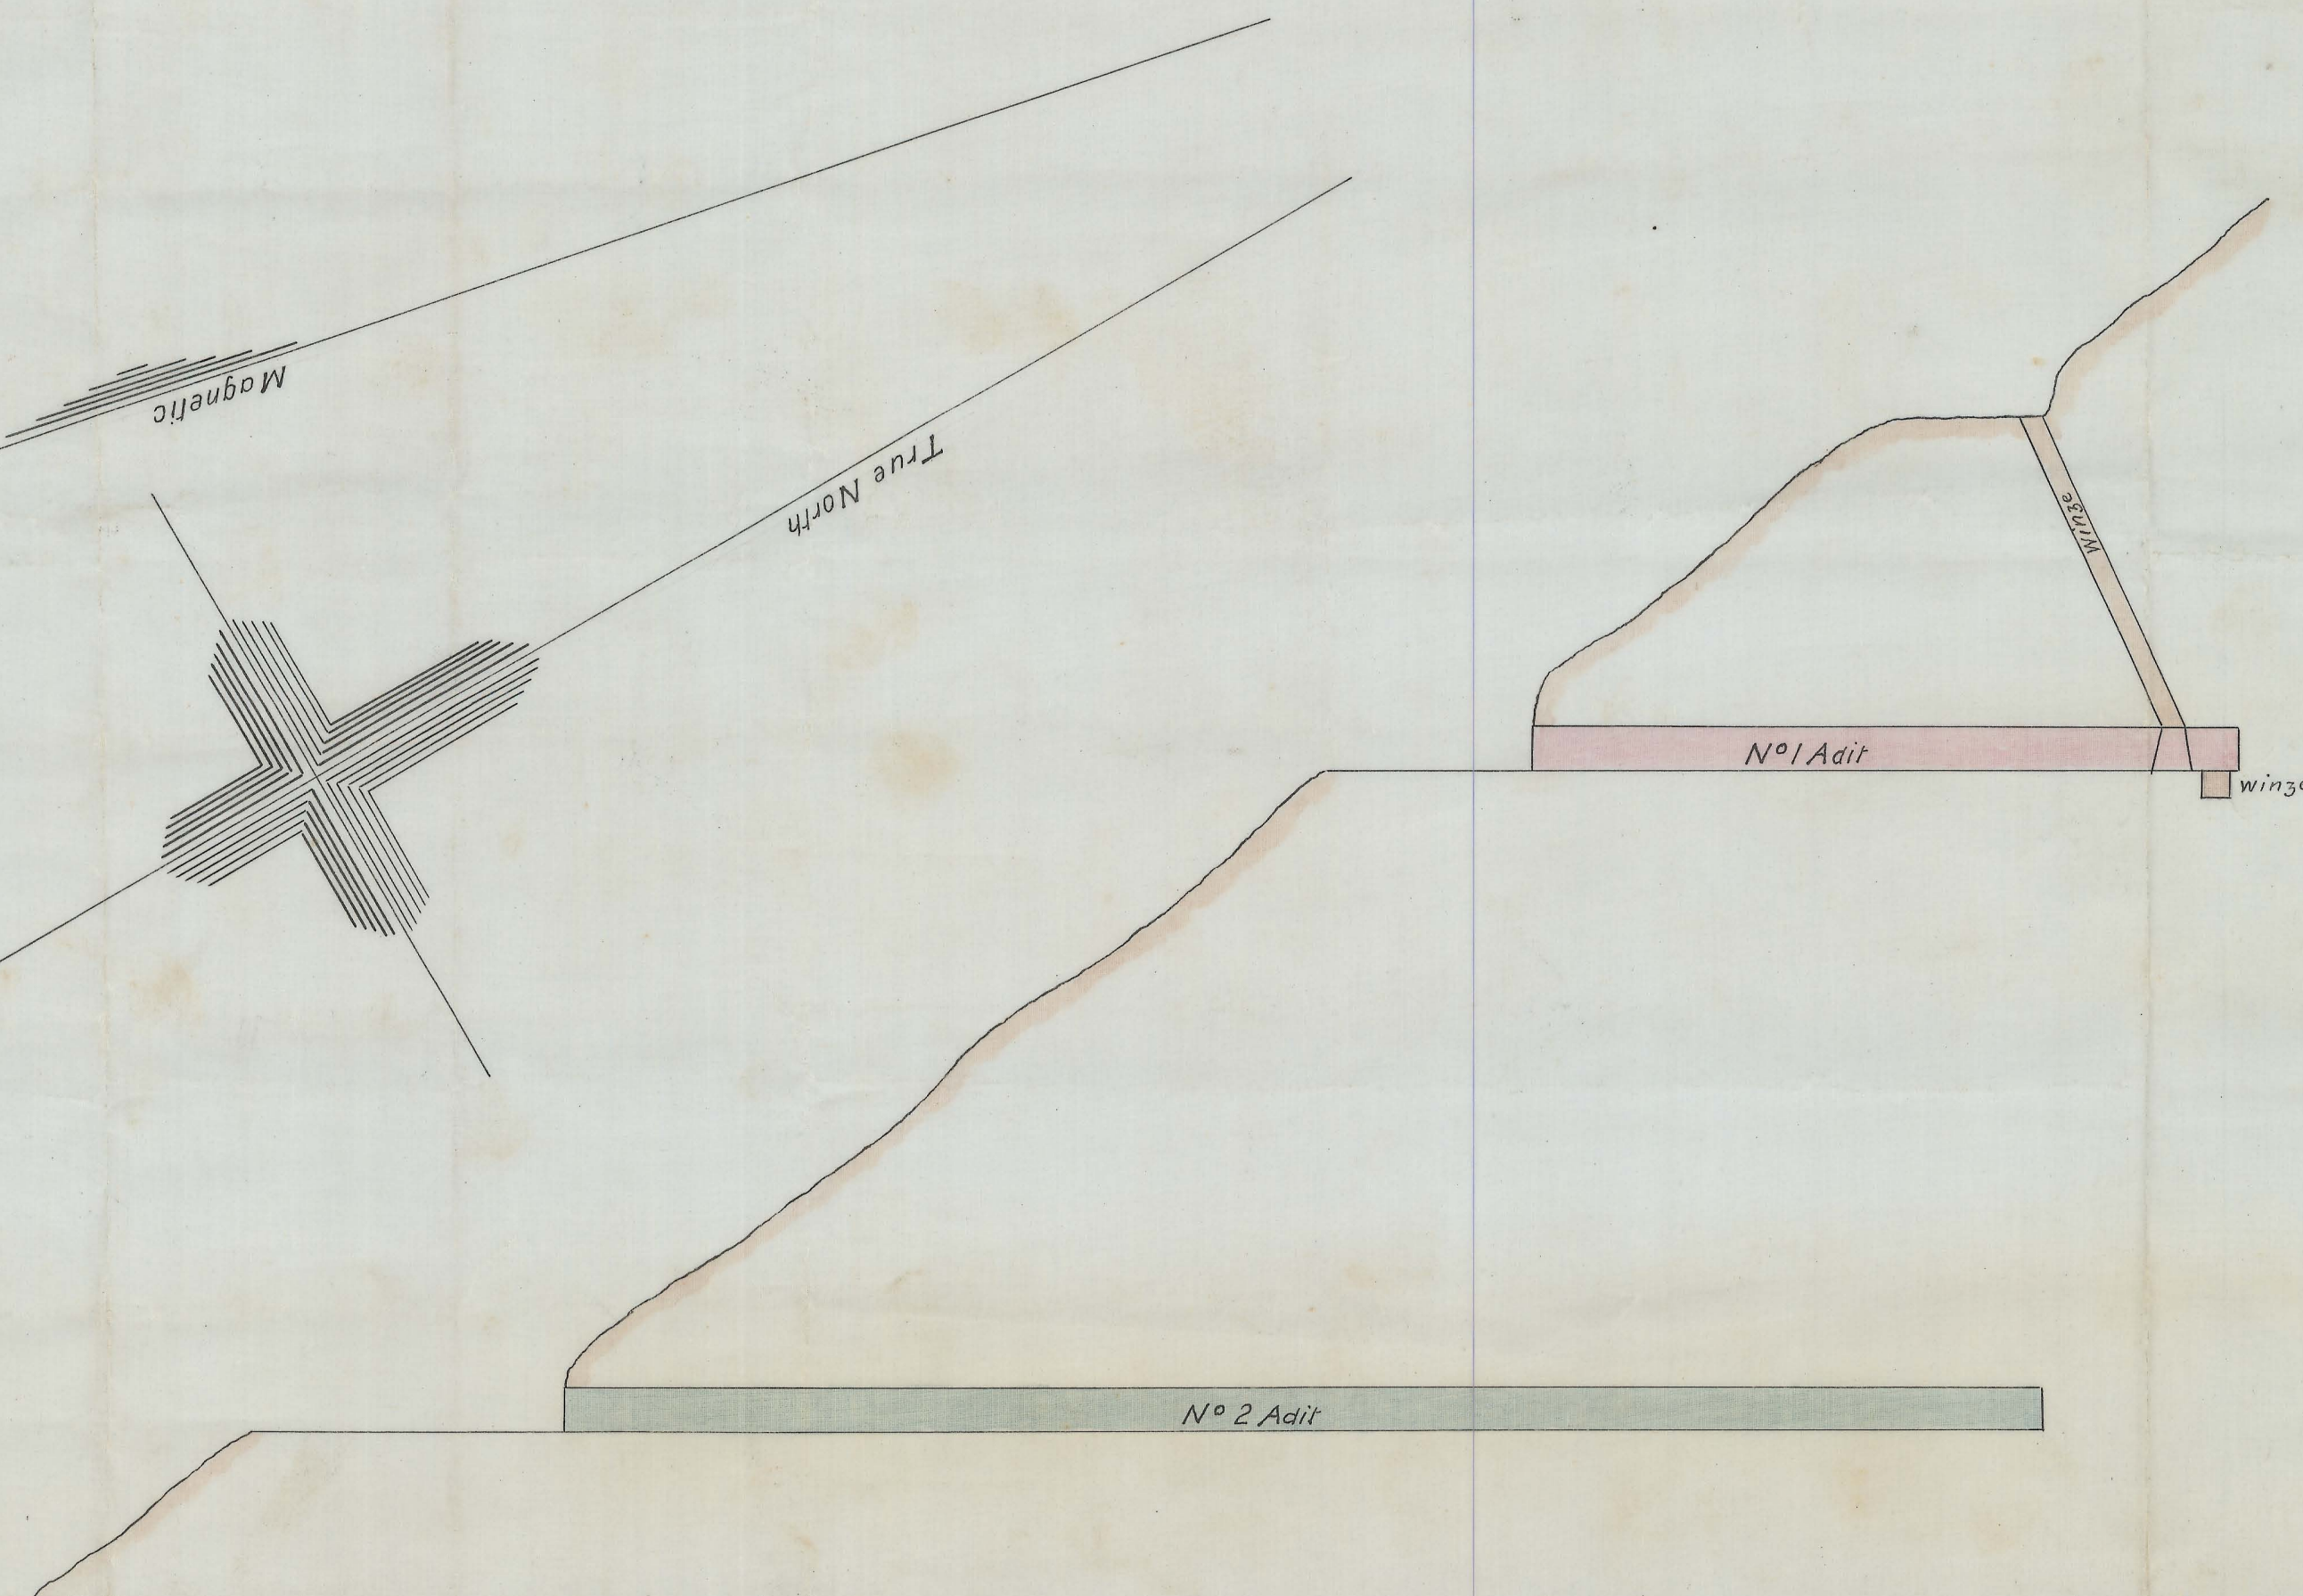

SECTION ON LINE OF ADITS

MINE WORKINGS
SOUTH WEST CURTIN-DAVIS

S. M. COY. No LIA.

MARCH 20th 1897

SCALE 25 FEET TO 1 INCH

R. F. Waller
Mining Surveyor
March 26 1906

