


SOUTH WEST CURTIN DAVIS MINING CO
 HORIZONTAL
 SECTION ALONG N° 2 LODE

SCALE 25 FEET TO AN INCH

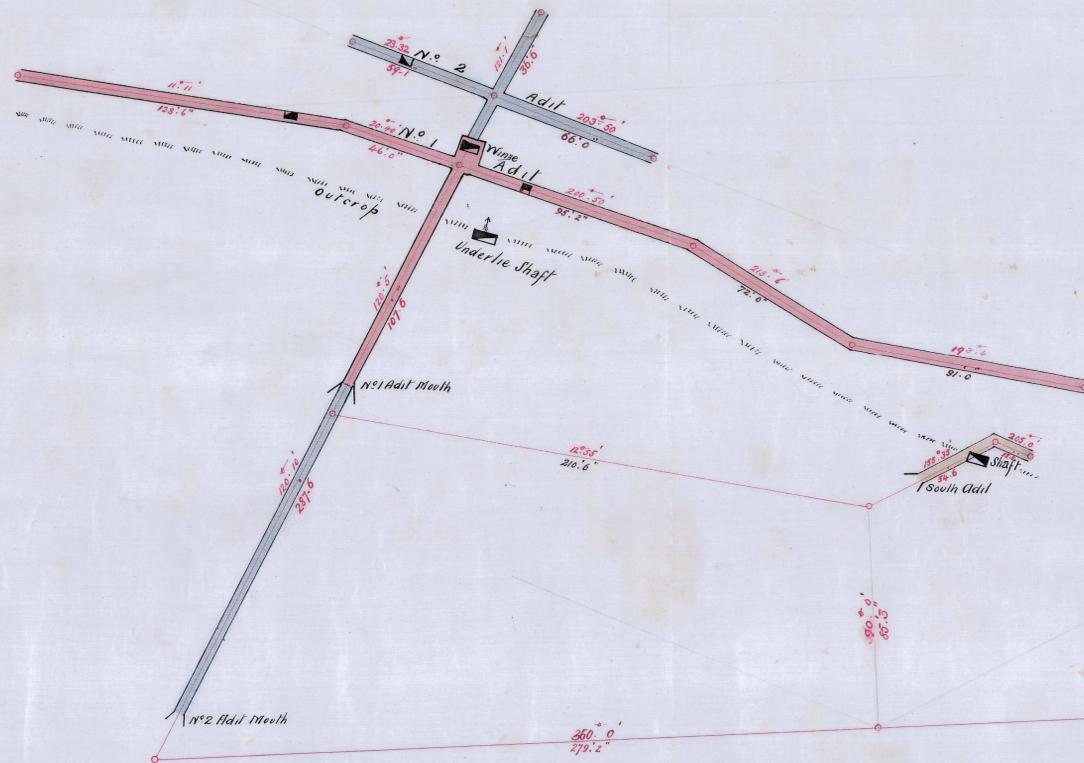

S.E. Corner Peg.

Boundary

South Curtin Davis
 Section 293 93 m 80 ac.

Went to Nelson
 Mining Coy
 24th October 1900

Plans not accepted
 Manager not Certified



2442-08

2442-02

