


244-01

244-01

5 cm

Survey No. 3
E.E.S. + 5015
M.L. 81W
101-101
101-101

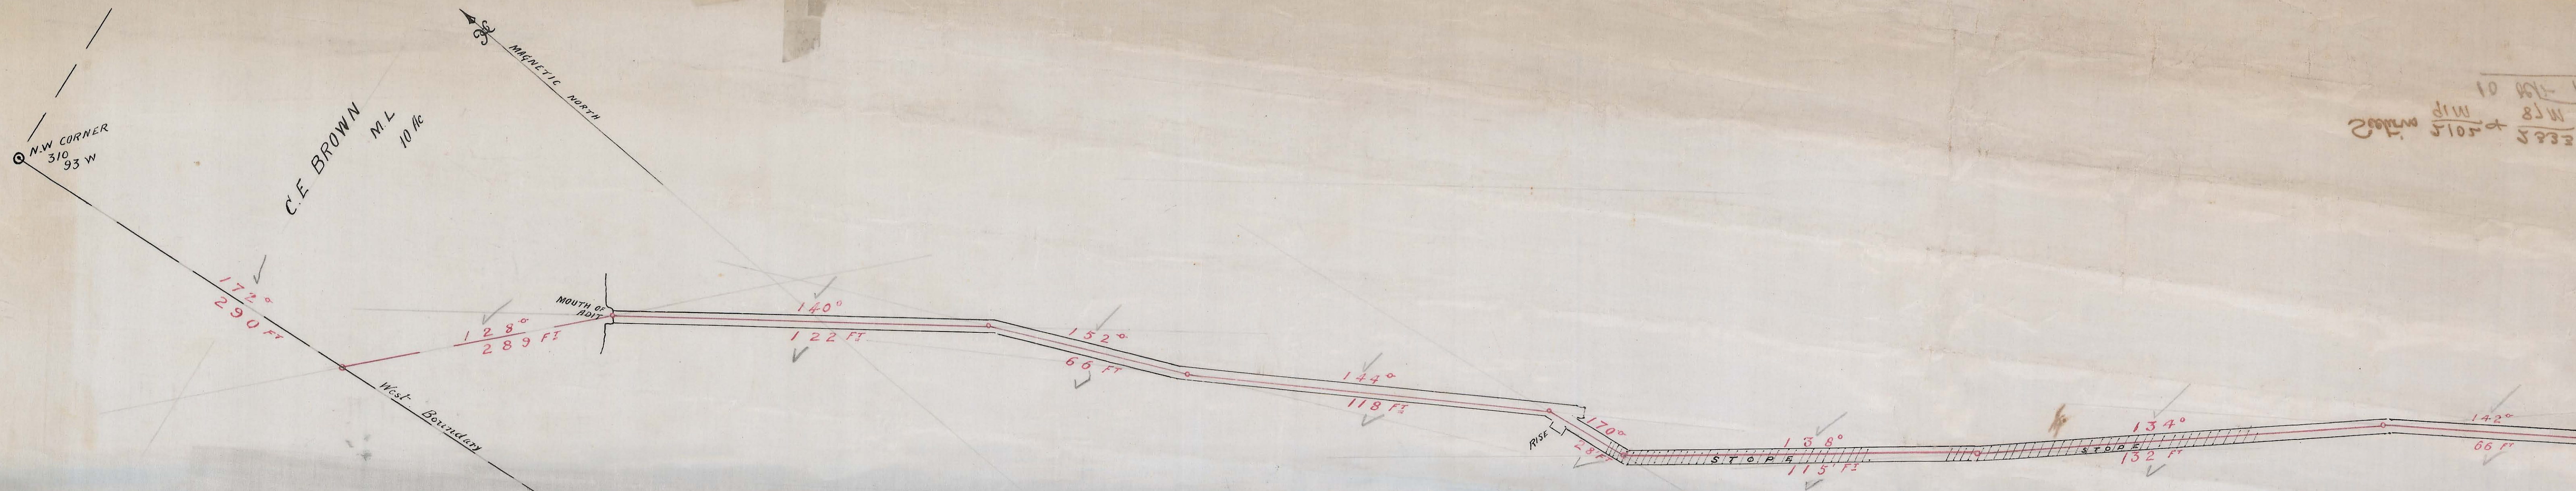

SCALE 25 FEET TO 1 INCH

W.R. Sale

Survey made with a Minner dial
August 22nd 1901

