


246-c1


THE ANCHOR TIN MINE LIMITED LOTTAH TASMANIA

Scale, 1 chain to one inch.

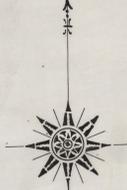

D

End of Steel Pipe at Race is 550 Feet above Fellen Wheel in Battery.

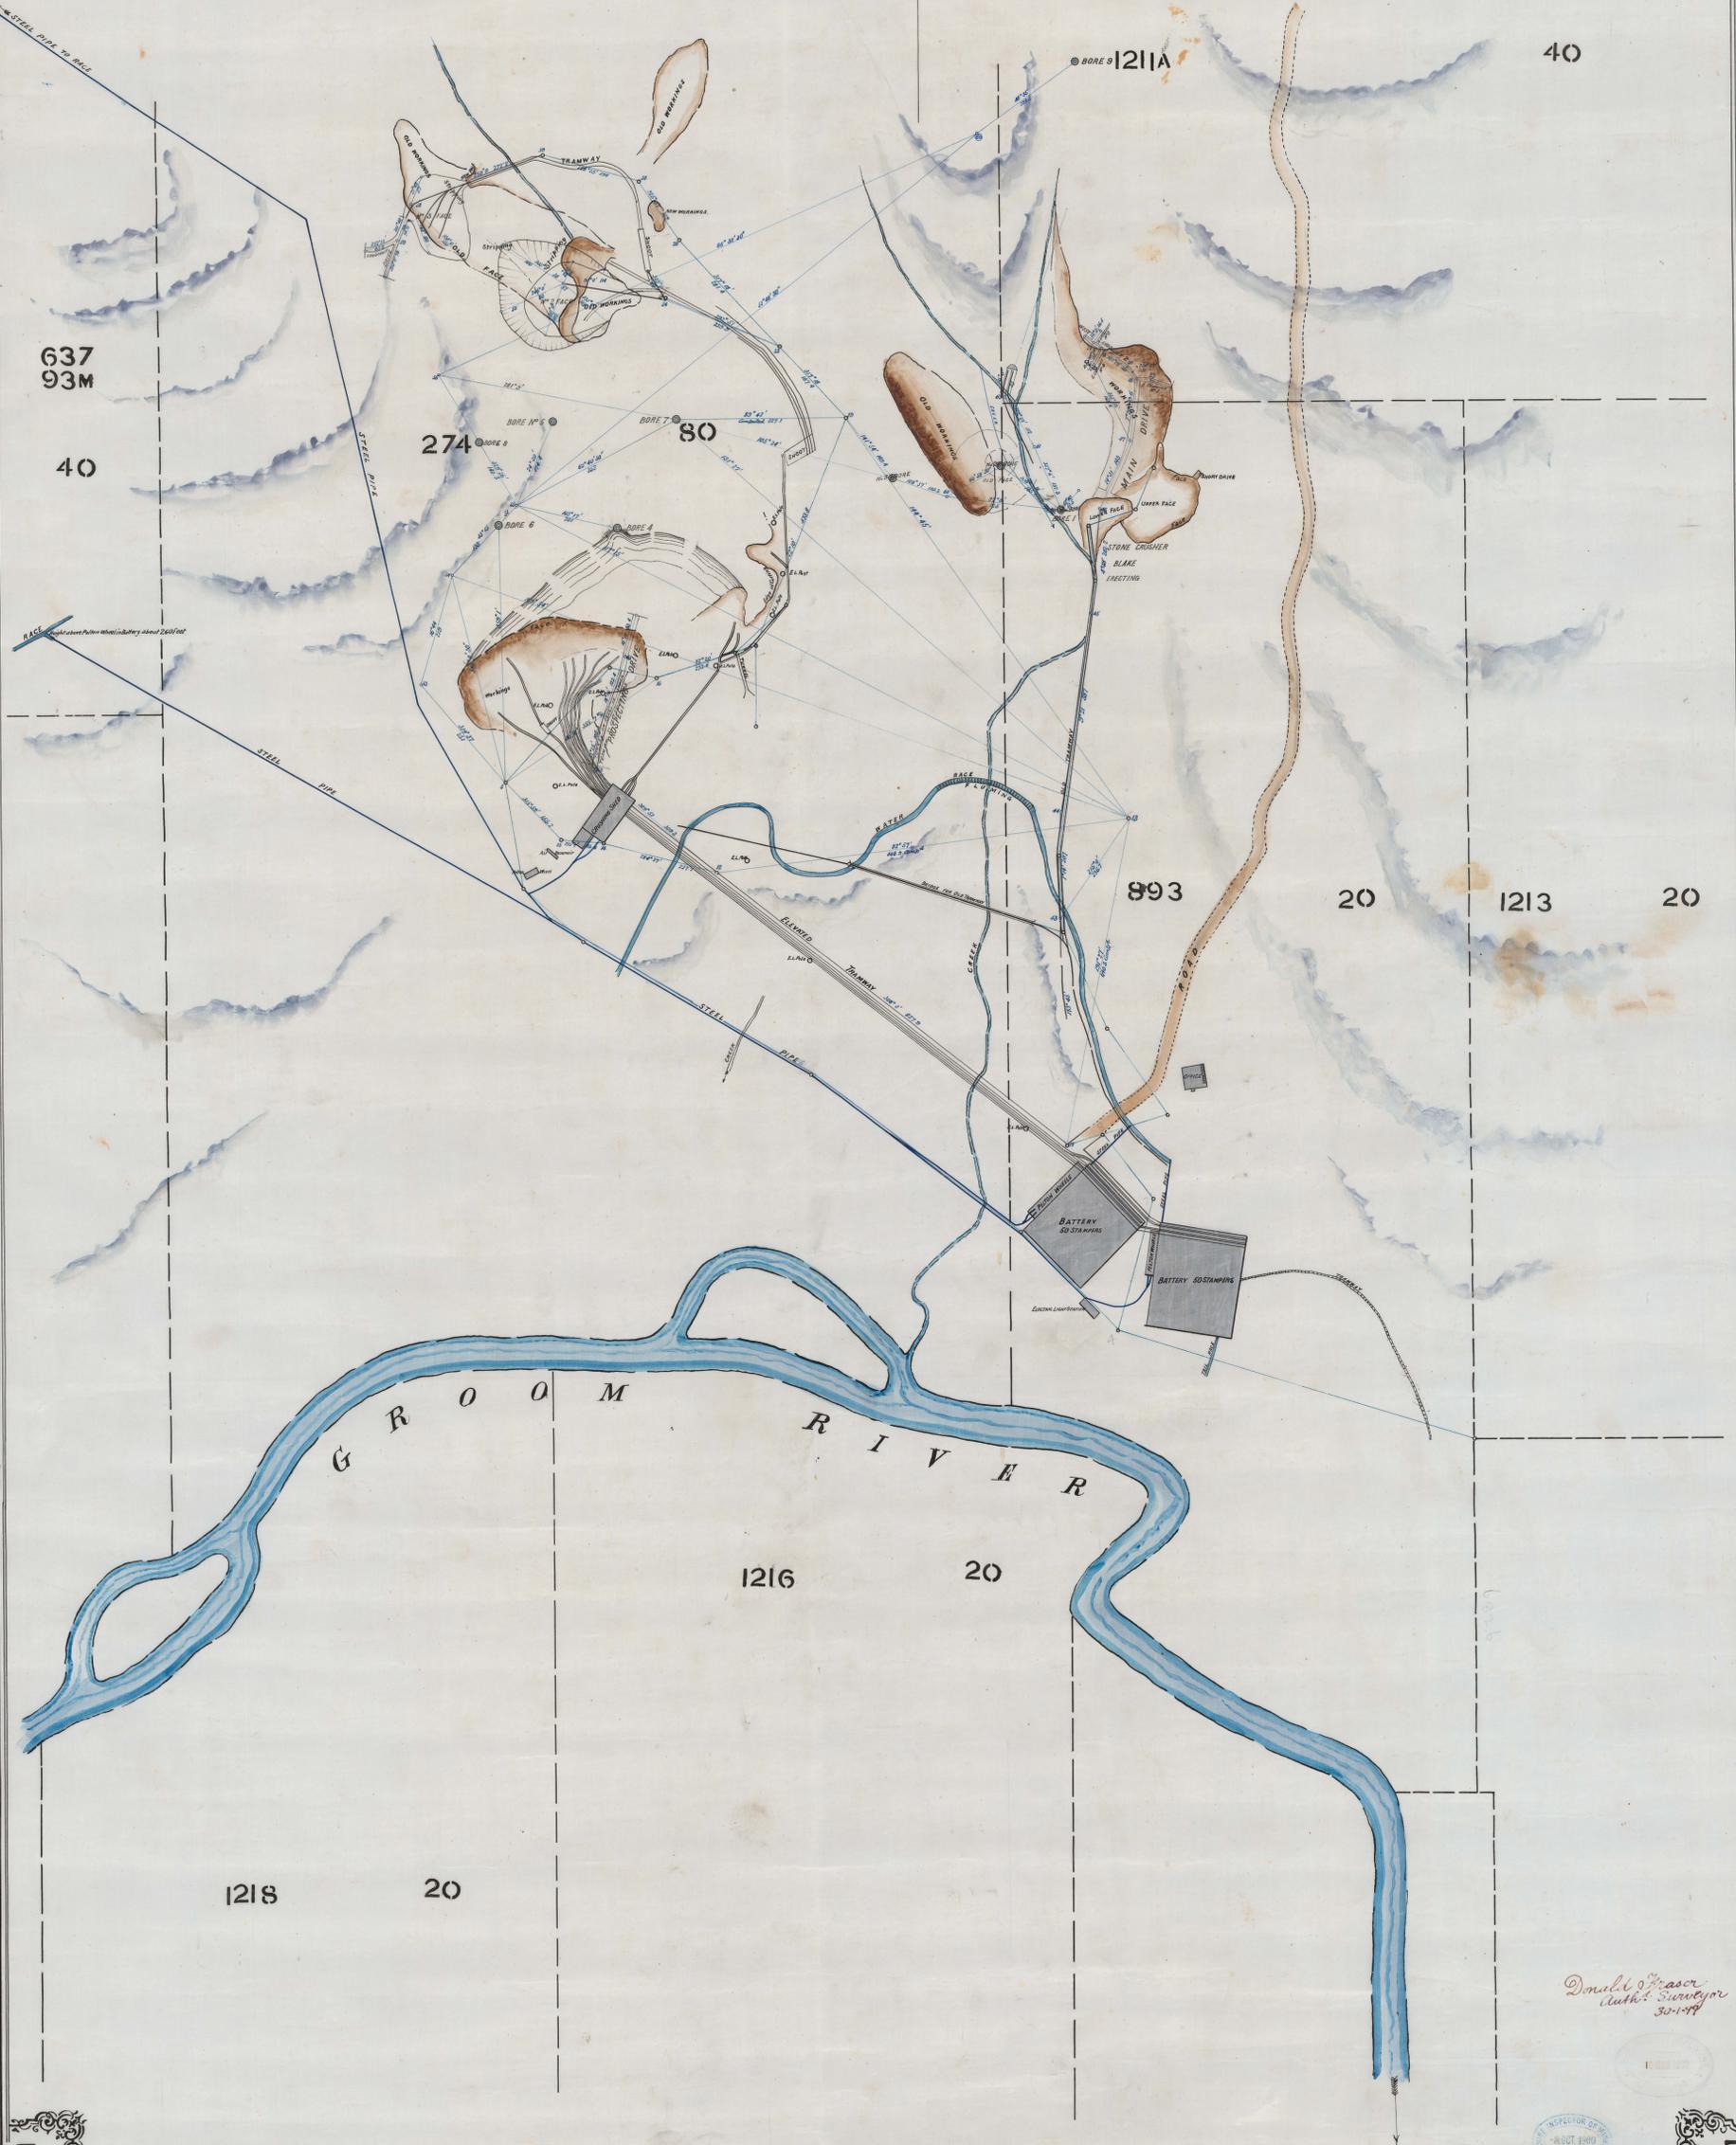

Donald Fraser
Civil Surveyor
30-1-1898

